

WATER SERVICE RECORD

Name Wynwood Associates Inc.

Service No. 171

Address 21 Douglas Road

7241

Location Lot #24 Sta 14+78

~~Renewal~~ New Service

Comm 9-19-60


Date	Material	Amount	Total	Date	Amount	
8-18-60	Labor	5.93		8-18-60	Deposit	100.00
	10% C.H.	.59	6.52	8-19-60	Refund	60.00
52'	3/4" Copper tubing @.42		21.84			39.94
1	3/4" C x 1/2" I.M.H. Stop & Waste		6.17		MDM CHARGE	
1	3/4" C 3 part union		2.41	1	1/2" Straight tailpiece	.50
1	hr. Trucking @3.00		3.00	1	1/2" Offset tailpiece	.50
			39.94			1.00
				8-18-60	Labor	3.62
				10'	3/4" Copper tubing @.42	4.20
				1	3/4" C Corp Cock	4.91
				1	Box & Rod	4.90
						18.64

DATE _____

TOWN OF LEXINGTON — BOARD OF PUBLIC WORKS

WATER DIVISION

Sketch of Service Here

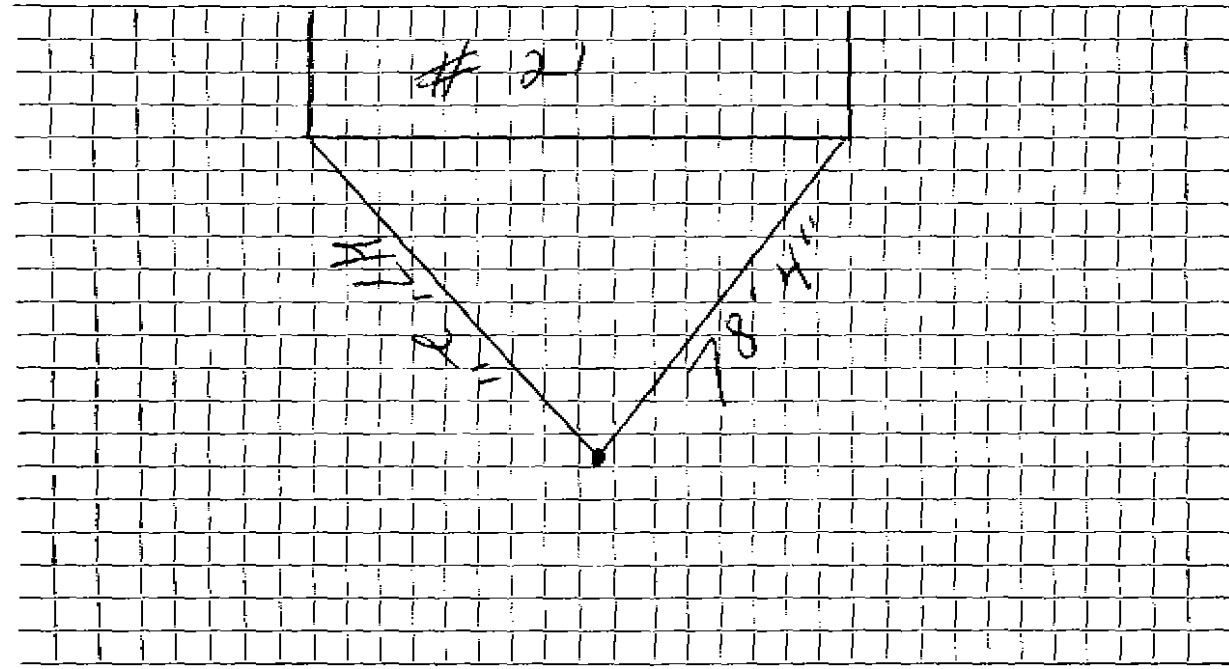

Connection made in Street. Work completed

Remarks:
.....
.....