

## WATER SERVICE RECORD

Name Wynwood Associates

Service No. 301

Address 26 Douglas Road

Location Lot #40 Ste. 18+12

~~Repair - Renewal~~ New Service


Comm 12-31-60

Date	Material	Amount	Total	Date		Amount
12-9-60	Labor	30.80		12-6-60	Deposit	100.00
	10% D.H.	3.08	33.88	12-5-60	Retund	11.16
64	3/4" Copper tubing @.42		26.88			88.84
1	3/4" C x 1/2 I.W.H. Stop & Waste		6.17		NON CHARGE	
1	3/4" C 3 part union		2.71	8-24-60	Labor	10.16
3	hrs. Pippin Shovel @4.50		13.50	28	3/4" Copper tubing @.42	11.76
2	hrs. Trucking @3.00		6.00	1	3/4" Corp Cock	4.91
			88.84	1	3/4" C Curb Cock	6.28
				1	Box & Rod	4.90
						38.01
				1	1/2 Straight tailpiece	.50
				1	1/2 Offset tailpiece	.50
						39.01

DATE \_\_\_\_\_

**TOWN OF LEXINGTON — BOARD OF PUBLIC WORKS**  
**WATER DIVISION**

Sketch of Service Here

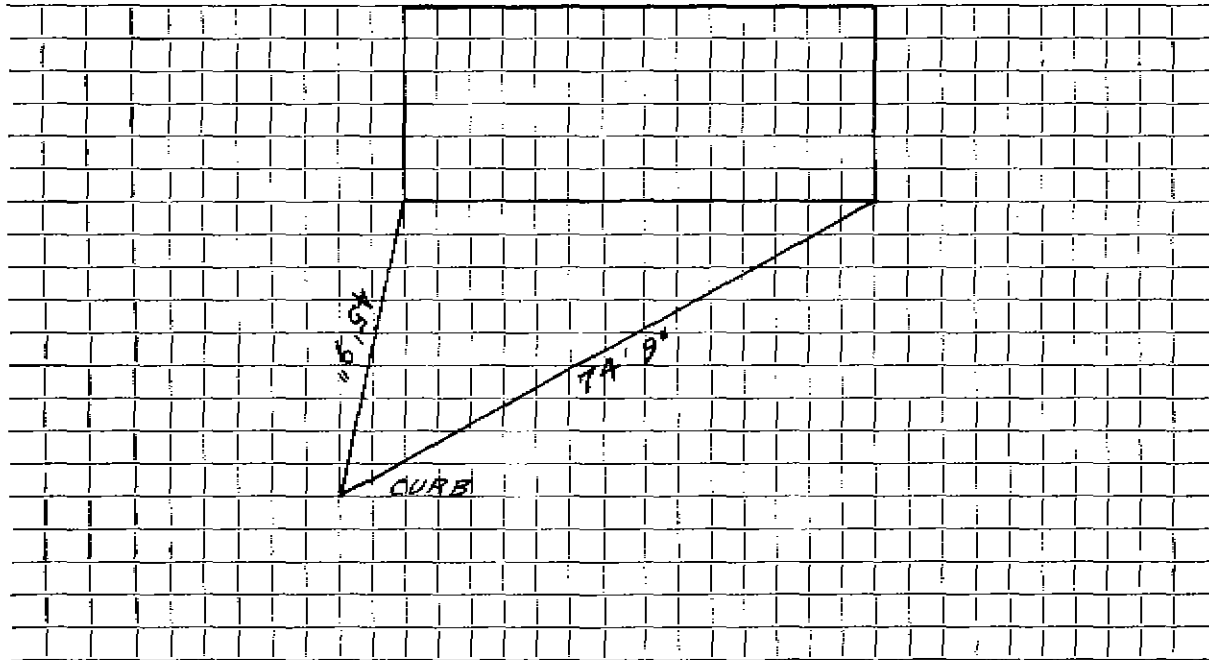

Connection made in ..... Street. Work completed .....

Remarks: .....

.....

.....