

WATER SERVICE RECORD

Name Wynwood Associates

Service No. 161

Address 27 Douglas Road

Location Lot#22 Sta. 18+30

Repair—Renewal—New Service


Comm 12-18-61

Date	Material	Amount	Total	Date	Amount
10/5/61	Labor	10 22			
11/28/61	" 10% O.H.	1 02	11 24	11-11-61	Deposit
	82' 3/4" Copper Tubing @ .42		34 44	12-18-61	Returned
	1 3/4" Cx 1/2 IWH Stop & Waste		6 17		
	1 3/4" C3 part Union		2 41		
	2 Hr. Trucking @ 3.00		6 00		
			60 26	8-26-60	Labor
					NON CHARGE
				9'	3/2" Copper tubing @.42
				1	3/4" C Corp Cock
				1	3/4" C Curb Cock
				1	Box & Rod
					23.14
				11/28/61	1 1/2 Straight Tailpiece
					1 1/2 Offset Tailpiece
					50
					50
					24 14

TOWN OF LEXINGTON — BOARD OF PUBLIC WORKS

WATER DIVISION

Sketch of Service Here

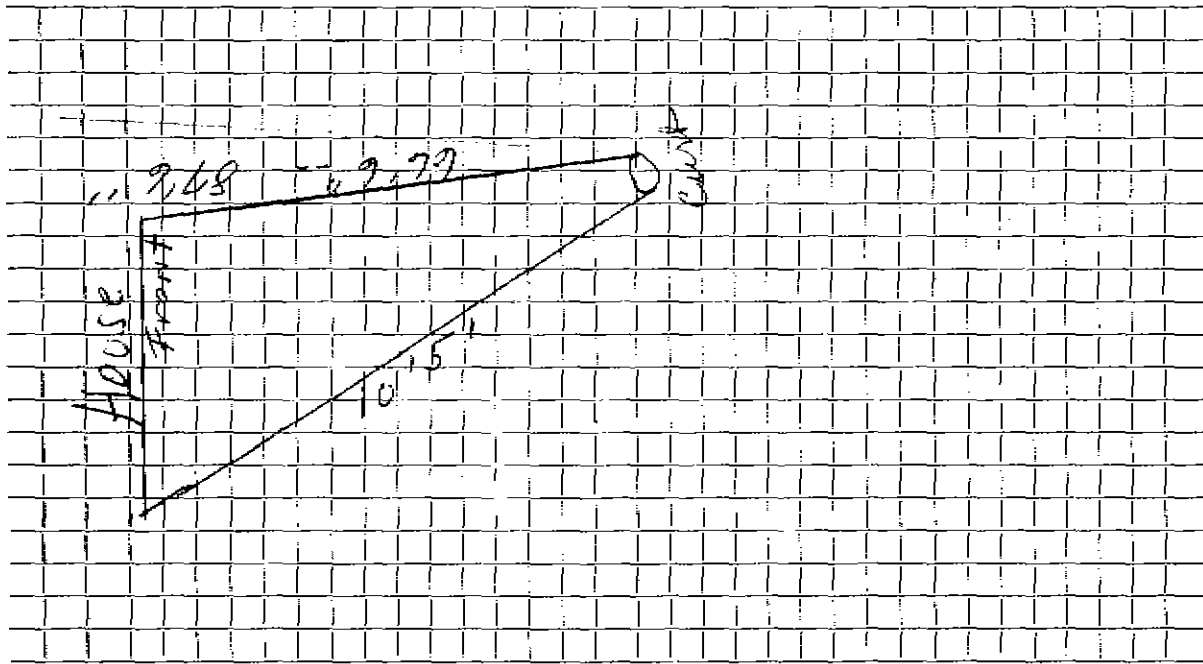

Connection made in Street. Work completed

Remarks:
.....
.....