

WATER SERVICE RECORD

Name Wynwood Associates

Service No. 202

Address 28 Douglas Road

Location Lot #11 Sta. 19+68

~~Repair - Renewal~~ - New Service

Comm 10-24-60


Date	Material	Amount	Total	Date	Material	Amount
9-30-60	Labor	46.84		9-30-60	Deposit	100.00
	10' O.H.	1.68	51.52	12-1-60	Fail	46.38
	84' 3/4" Copper tubing @.42	35.28	35.28			140.38
	1 3/4" C x 1/2" I.A.H. Stop & Waste	6.17			NO CHARGE	
	1 3/4" C 3 part union	2.41		8-26-60	Labor	9.80
	6 hrs. Pippin Shovel @ 6.50	39.00		27'	3/4" Copper tubing @.42	11.34
	2 hrs. Trucking @3.00	6.00		1	3/4" C Corp Cock	4.91
		140.38		1	3/4" C Curb Cock	6.28
				1	Box & Rod	4.90
						37.23
				9-30-60	Shovel broken down Labor	11.52
					1 1/2 Straight tailpiece	.50
					1 1/2 Offset tailpiece	.50
						49.75

DATE _____

TOWN OF LEXINGTON — BOARD OF PUBLIC WORKS

WATER DIVISION

Sketch of Service Here

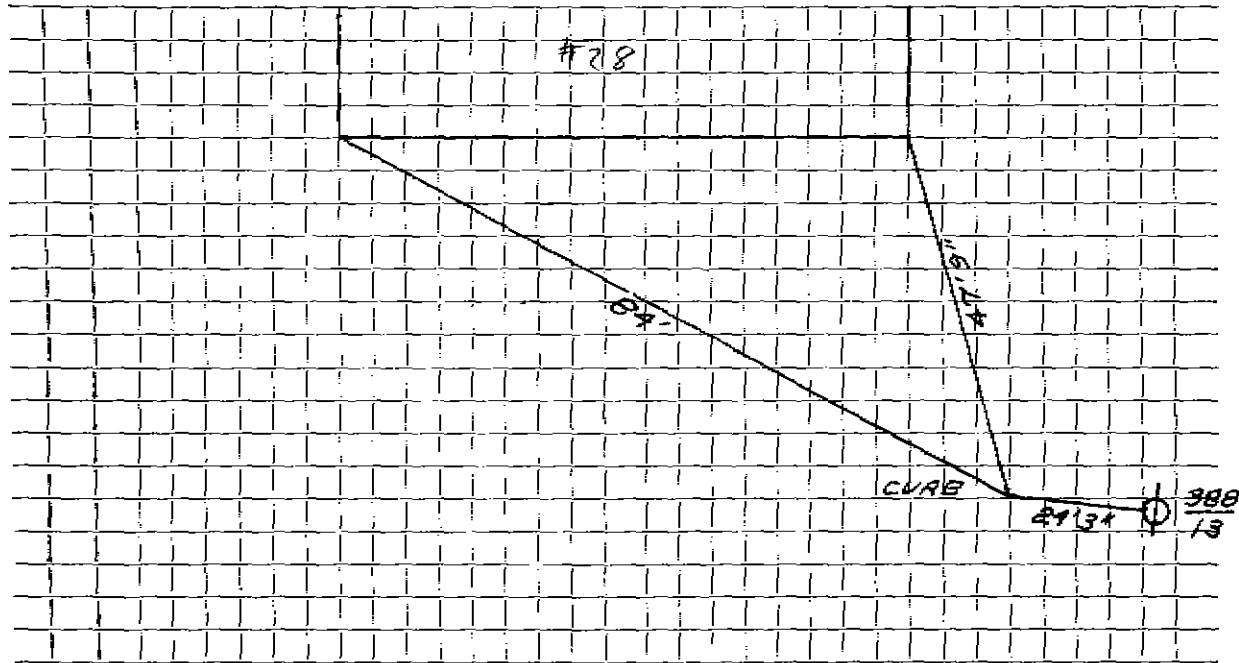

Connection made in Street. Work completed

Remarks:
.....
.....