

WATER SERVICE RECORD

1646

Name Wynwood Assoc.

Service No. 40

Address 3 Douglas Road

Location

~~Repair -~~ ~~Replace~~ New Service


Comm 7-5-60

Date	Material	Amount	Total	Date	Amount
4-14-60	Labor	23.91		4-14-60	100 00
	10% O.H.	2.39		4-15-60	15 74
			26 30		<u>84 26</u>
6/4'	3/4" Copper tubing		26 88		
1	3/4" Cx 1/2 I.W.H. Stop & Waste		6 17		
					<u>NON CHARGE</u>
1	3/4" C 3 Part Union		2 41	9-19-59	Labor
3	Hrs. Town Shovel @ 6.50		19 50	12'	3/4" coppertubing @.38
1	Hr. Trucking @ 3.00		3 00	1	3/4" C Corp Cock
			<u>84 26</u>	1	3/4" C Curb Cock
				1	Box & Rod
				1	Hr. Trucking
					<u>75</u>
					24 82
				1	1/2 Straight tailpiece
				1	1/2 Offset tailpiece
					<u>50</u>
					25 82

DATE _____

TOWN OF LEXINGTON — BOARD OF PUBLIC WORKS
WATER DIVISION

Sketch of Service Here

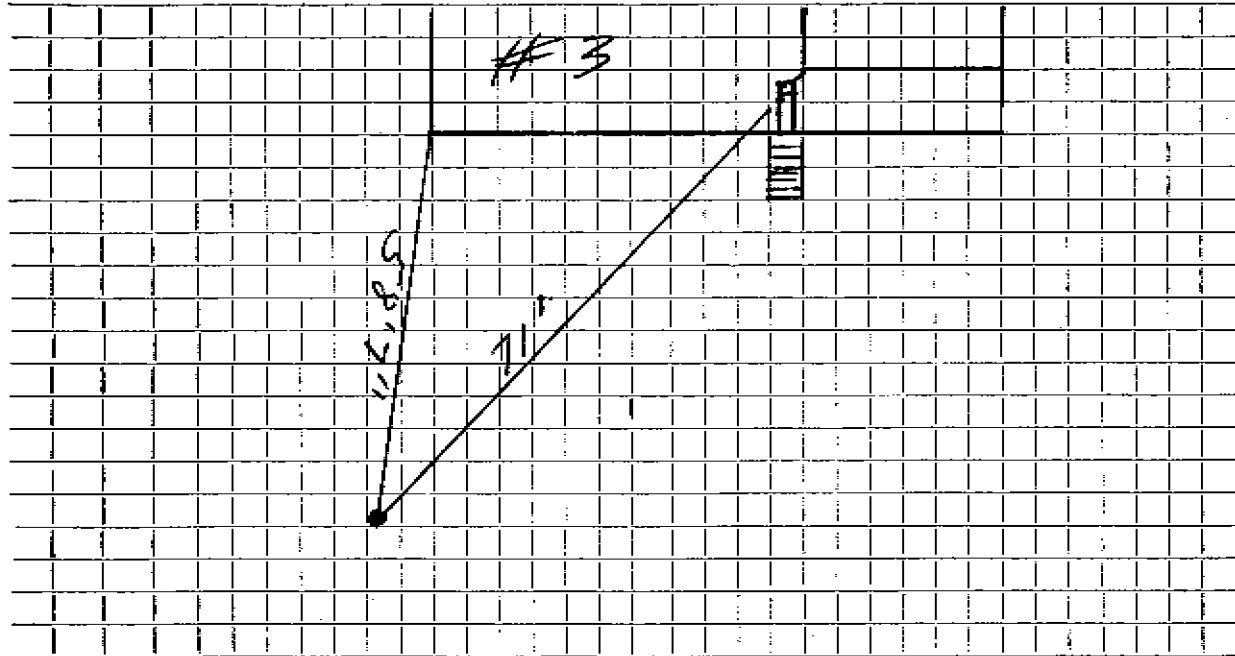

Connection made in Street. Work completed

Remarks:
.....
.....