

## WATER SERVICE RECORD

Name Wynwood AssociatesService No. 81Address 30 Douglas RoadLocation Lot #42 Sta. 21+12~~Basic Water~~ New ServiceComm 7-17-61


Date	Material	Amount	Total	Date		Amount
6-21-61	Labor	2.00		6-14-61	Deposit	100.00
	10% O.H.	.20	2.20	7-17-61	Retard	6.34
60'	3/4" Copper Tubing @.42		25.20			36.57
1	3/4" C x 1/2 I.W.R. Stop & Waste	6.17			NON CHARGE	
1	Hr. Trucking @3.00		3.00	8-13-60	Labor	8.71
			36.57		24' 3/4" Copper tubing @.42	10.08
					1 3/4" C Corp Cock	4.91
					1 3/4" C Curb Cock	6.28
					1 Box & Rod	4.90
						34.88
				6-21-61	1 1/2 Straight tailpiece	.50
					1 1/2 Offset tailpiece	.50
						35.88

DATE \_\_\_\_\_

TOWN OF LEXINGTON — BOARD OF PUBLIC WORKS

**WATER DIVISION**

Sketch of Service Here

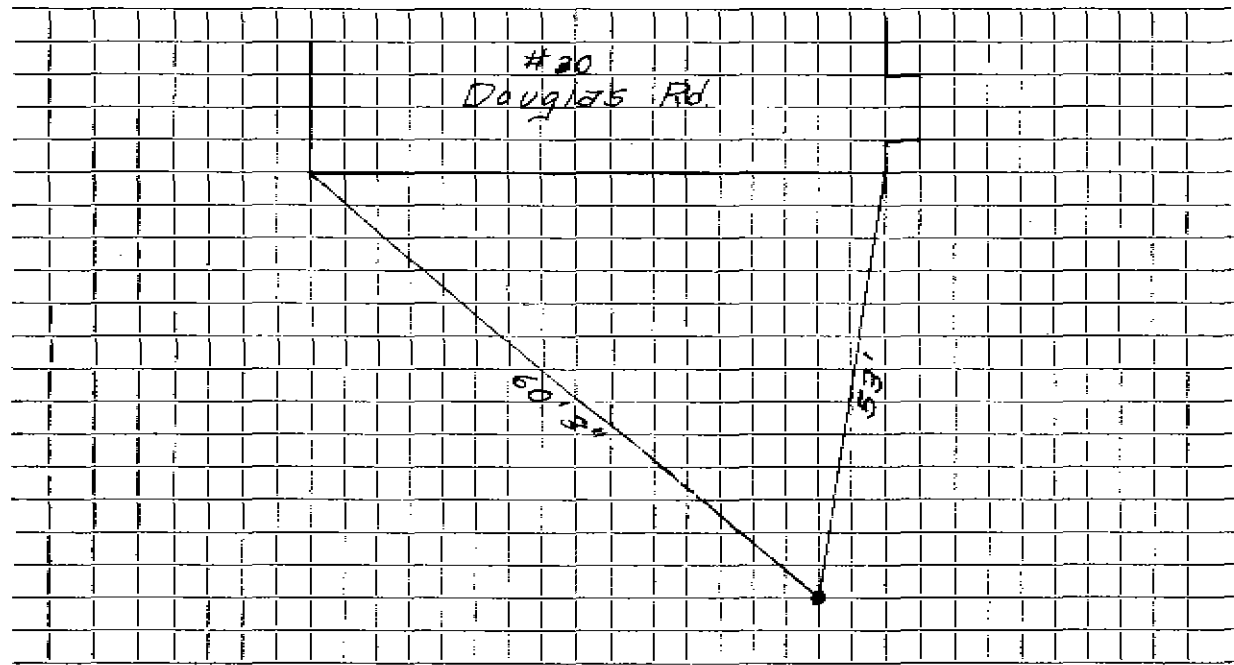

Connection made in ..... Street. Work completed .....

Remarks: .....  
.....  
.....