

WATER SERVICE RECORD

Name Wynwood Associates

Service No. 121

Address 4 Douglas Road

#6902

Location

Repair-~~REPAIR~~-New Service


Comm 9-25-61

Date	Material	Amount	Total	Date		Amount
8-24-61	Labor	15.42		8-23-61	Deposit	100.00
	10% O.H.	1.54	16.96	9-25-61	Refund	40.38
7/4"	3/4" Copper Tubing @.42		31.08			59.62
1	3/4" c x 1/2 I.W.H. Stop & Waste		6.17		<u>NON CHARGE</u>	
1	3/4" C3 part union		2.41	9-19-59	Labor	8.79
1	Hr. Trucking @3.00		*** 3.00	28'	3/4" Copper tubing @.38	10.64
			59.62	1	3/4" C Corp Cock	4.67
				1	3/4" C Curb Cock	6.07
				1	Box & Rod	5.00
				1	Hr. Trucking	7.75
						35.92
				1 1/2	Straight tailpiece	.50
				1 1/2	Offset tailpiece	.50
						36.92

DATE _____

TOWN OF LEXINGTON — BOARD OF PUBLIC WORKS
WATER DIVISION

Sketch of Service Here

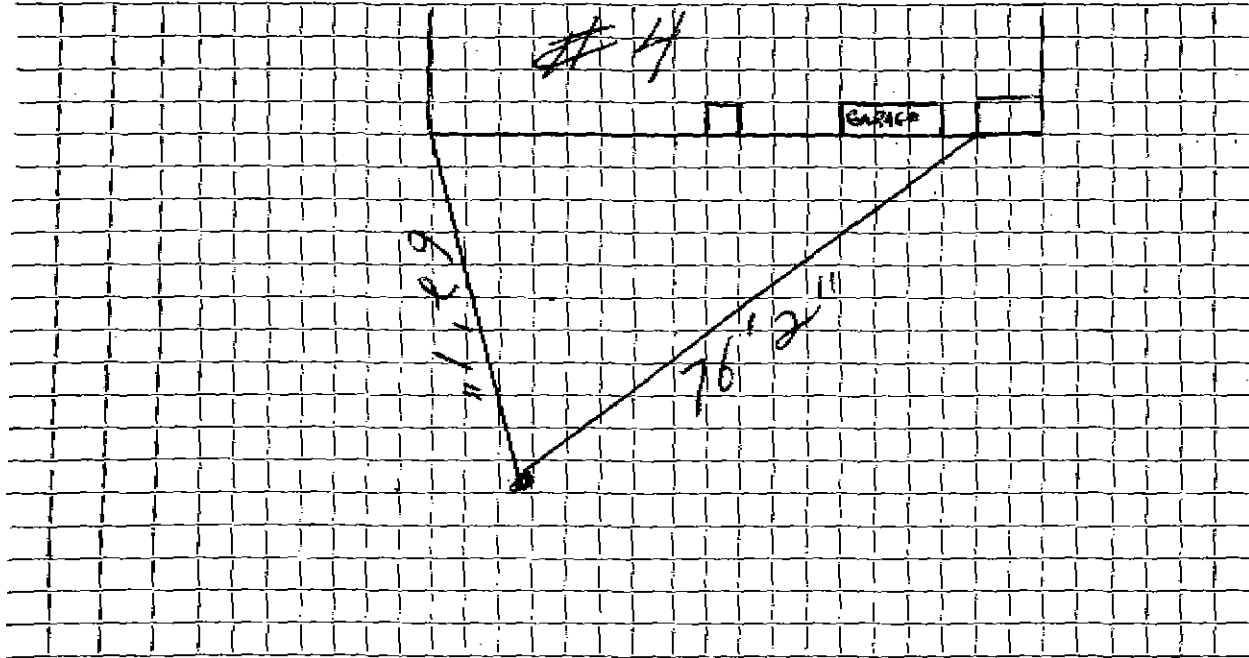

Connection made in Street. Work completed

Remarks:

.....
.....