

WATER SERVICE RECORD

Name Wynwood Associates Inc.

Service No. #203

Address 8 Douglas Road

Location Lot #32 Sta 5+99

Repair—Renewal—New Service WO #6997

Plan 6-25-62


Date	Material	Amount	Total	Date	Material	Amount
5-7-62	Labor	17.78		12-8-61	Deposit	100.00
	10% O.H.	1.78	19.56	4-25-62	Retard	33.16
85'	3/4" Copper tubing @.42		35.70			66.84
1	3/4" C X 1/2 I.W.E. Stop & Waste	6.17			NO CHARGE	
1	3/4" C3 Part Union	2.41	8-26-60	Labor		9.08
1	Hr. Trucking @3.00	3.00		25'	3/4" Copper tubing @.42	10.50
			66.84	1	3/4" C Corp Cock	4.91
				1	3/4" C Curb Cock	6.28
				1	Box & Rod	4.90
						35.67
				5-7-62	1 1/2 Straight tailpiece	.50
					1 1/2 Offset tailpiece	.50
						36.67

DATE _____

TOWN OF LEXINGTON — BOARD OF PUBLIC WORKS

WATER DIVISION

Sketch of Service Here

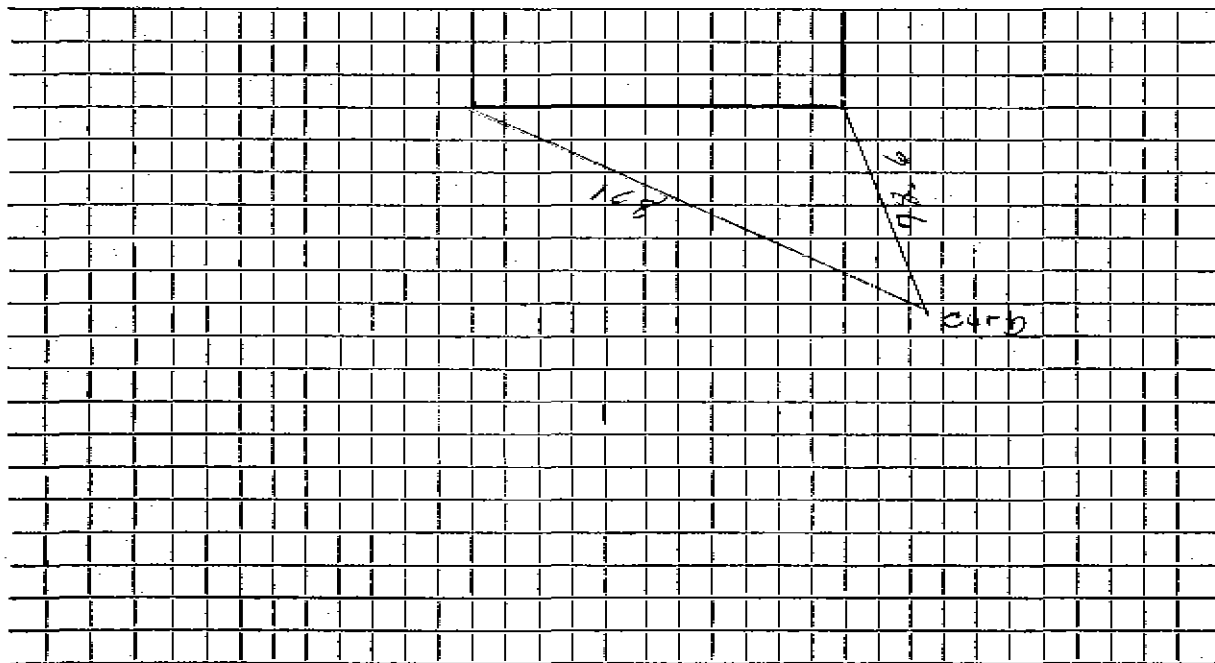

Connection made in Street. Work completed

Remarks:

.....

.....