

**WATER SERVICE RECORD**

Name \_\_\_\_\_

**Service No.**

Address 1 DOVER LANE LOT # 3

100

### **Location**

## Repair—Renewal ← New Service

Date	Material	Amount	Total	Date		Amount
8/86	13.5 LF 1" COPPER 1" CORP 1" CURE w/Box					
3/87	65 LF 1" COPPER					


DATE \_\_\_\_\_

TOWN OF LEXINGTON — BOARD OF PUBLIC WORKS

**WATER DIVISION**

Sketch of Service Here

LOT #3

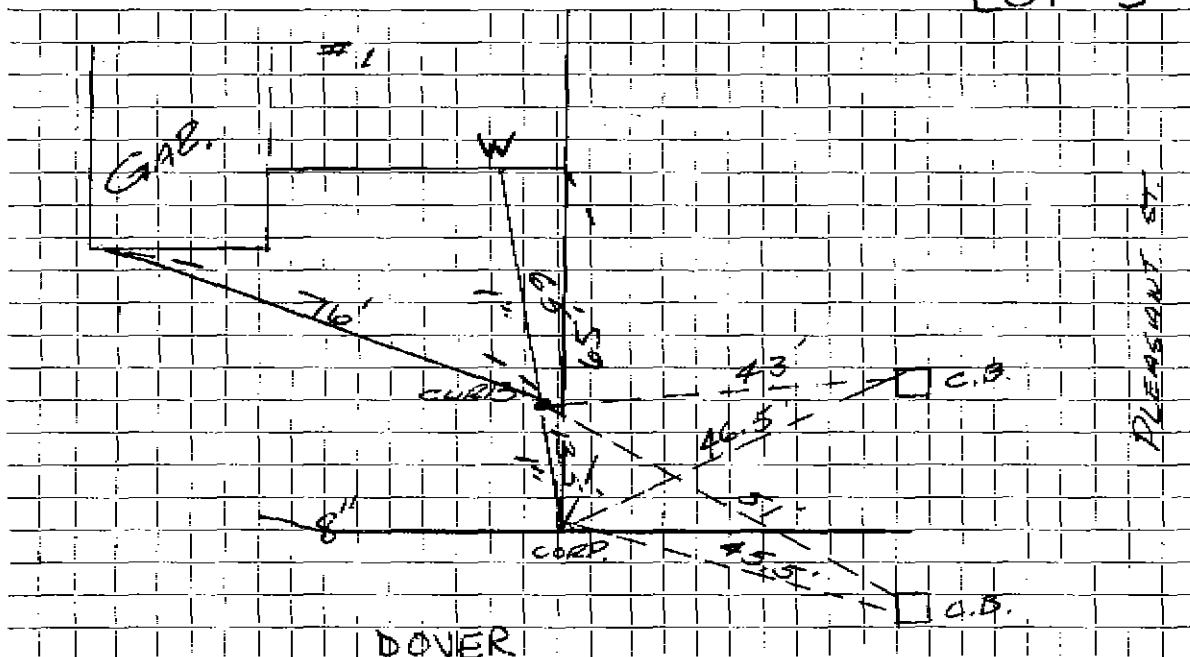

Connection made in DOVER LANE Street. Work completed .....

Remarks: .....