

WATER SERVICE RECORD

Name

Service No.

Address #

33 Dover Lane (EXIST. HOUSE #91 PLEASANT ST.)

Location

Repair—Renewal (New Service)

Date	Material	Amount	Total	Date	Amount
Aug. 4, 26	① 1" COP ① 4' x 8" BOT 28' 0" 0-1" COPPC.				

Note

When House connects to this service the existing service on Pleasant St. will be used for the proposed lot #4 on Pleasant St.


DATE _____

TOWN OF LEXINGTON — BOARD OF PUBLIC WORKS

WATER DIVISION

EXIST. House

Sketch of Service Here

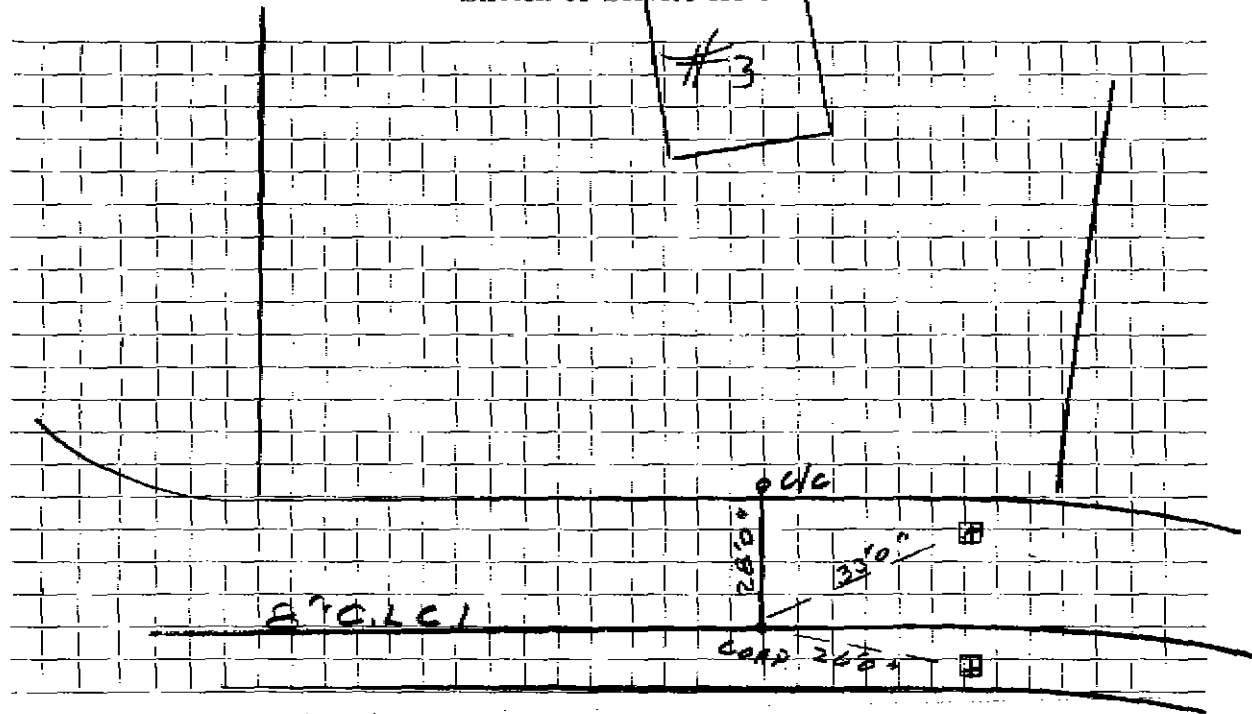

Connection made in Street. Work completed

Remarks:
.....
.....