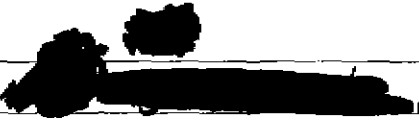


WATER SERVICE RECORD

Name

Service No.

Address

 #7 Dover Lane

Location

Repair—Renewal (New Service)


Date	Material	Amount	Total	Date	Amount
Aug. 4, 86	① 1" Copr. ① C/c & Bot 450' of 1" Copper				
Dec. 29, 86	790' of 1" Copper				

DATE _____

TOWN OF LEXINGTON — BOARD OF PUBLIC WORKS

WATER DIVISION

Sketch of Service Here

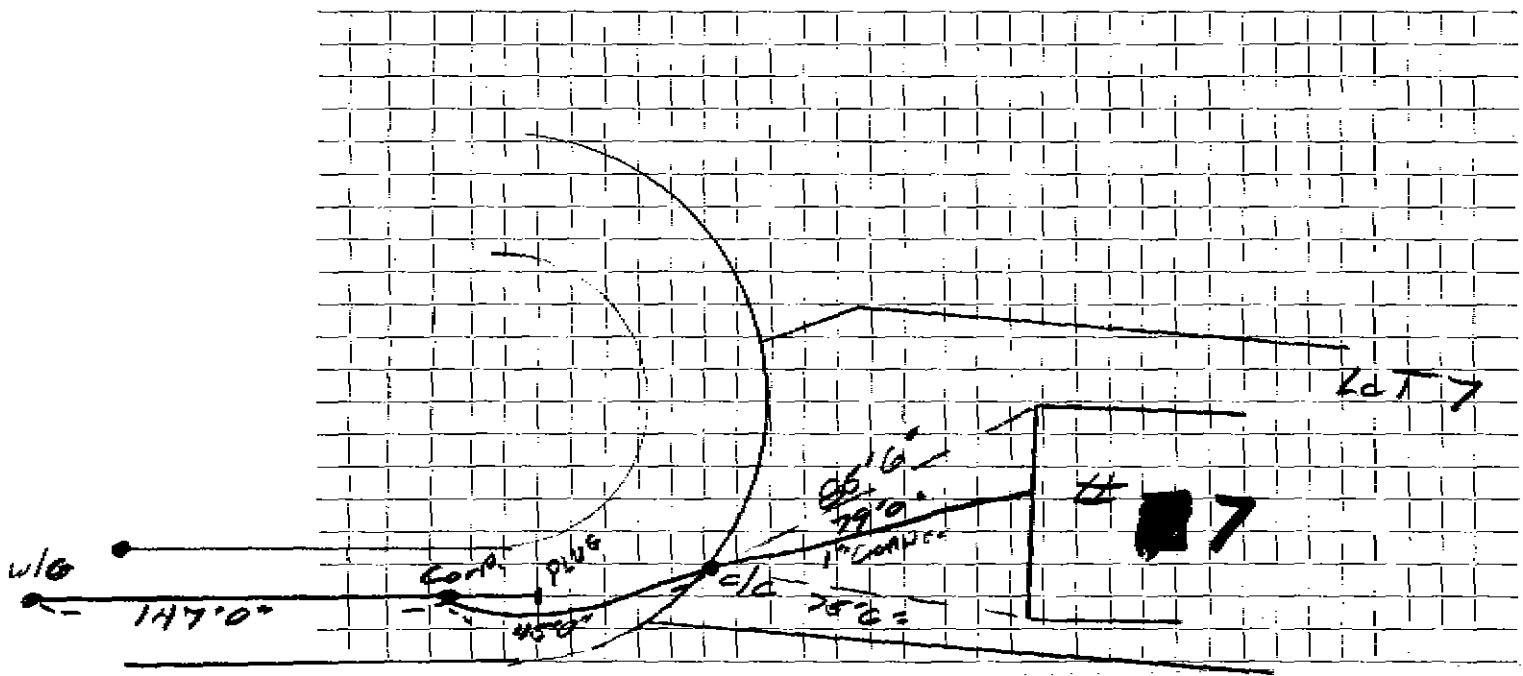

Connection made in Street. Work completed

Remarks:

.....

.....