




DATE \_\_\_\_\_

TOWN OF LEXINGTON — BOARD OF PUBLIC WORKS  
WATER DIVISION

Sketch of Service Here

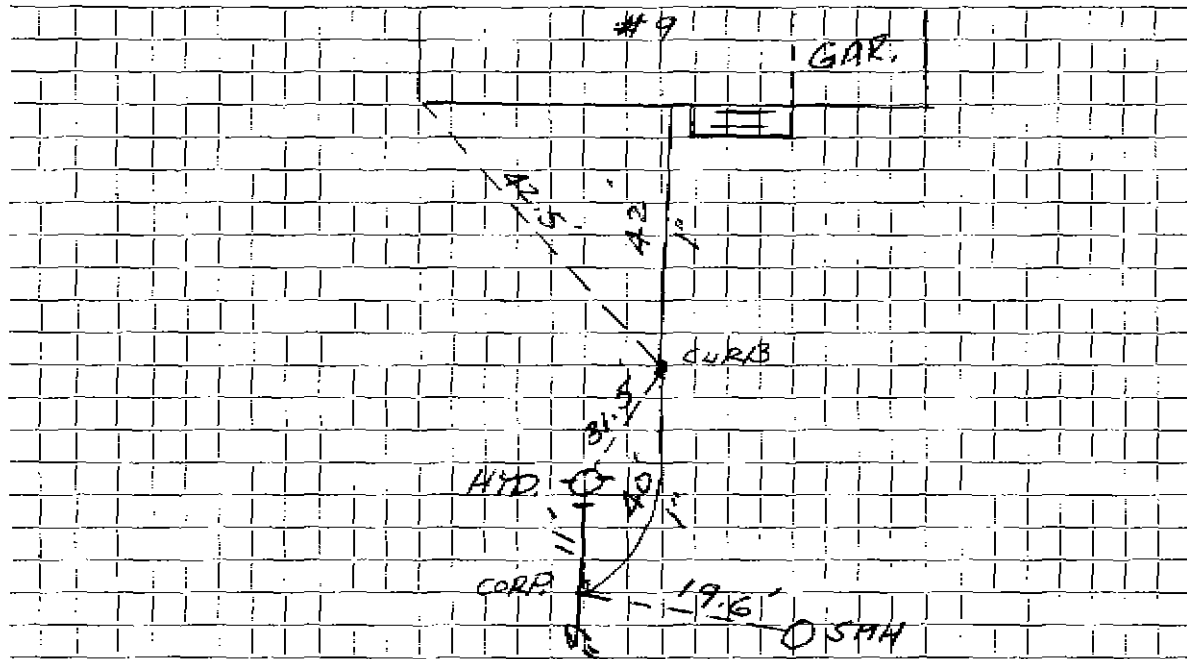

Connection made in DOVER LANE Street. Work completed .....

Remarks: .....  
.....  
.....