

Name Courtney Comeau
 Address 11 Downing Road
 Lexington, Mass.

Service No. 73

4169
 # 6715

Location 11 Downing Road

Kind of Pipe

Size

Size of Main

~~Repair~~ ~~Renewal~~ New Service

Con. 5/22/50

Location

Date	Material	Amount	Total	Date	Location	Amount
May 4, '50	Labor	3 00	3 00	April 29 '50	Deposited	60 00
	10% Overhead		30	May 4 '50	Refund	27 30
	32' - 3/4" Copper Tubing @.23		7 36		No Charge	32 70
	1 - 3/4" C x 1/2" I.W.H. S&W		3 29	May 4, '50	Labor	17 30
	Trucking 1 hr. @.75		75		31' - 3/4" Copper Tubing @.23	7 13
	Patching 18 x 3		18 00		1 - 3/4" C Corp-cock	3 15
			32 70		1 - 3/4" C x 3/4" C Curb-cock	3 85
					1 - Box & Rod	3 70
					1 - 1/2" Straight Tail Piece	38
					1 - 1/2" Offset Tail Piece	38
					Littlefield Shovel 2 hrs. @ 7.00	14 00
					Trucking 1 hr. @.75	75
	Labor					50 64

TOWN OF LEXINGTON - BOARD OF PUBLIC WORKS

WATER DIVISION

The undersigned applies for a supply of water at No..... St. and hereby agrees to comply with the rules and regulations as now, or at any future time, established by the Board of Selectmen.

Am't of Estimate \$.....


Owner

Am't Paid \$.....

Address

Builder

Sketch of Service Here

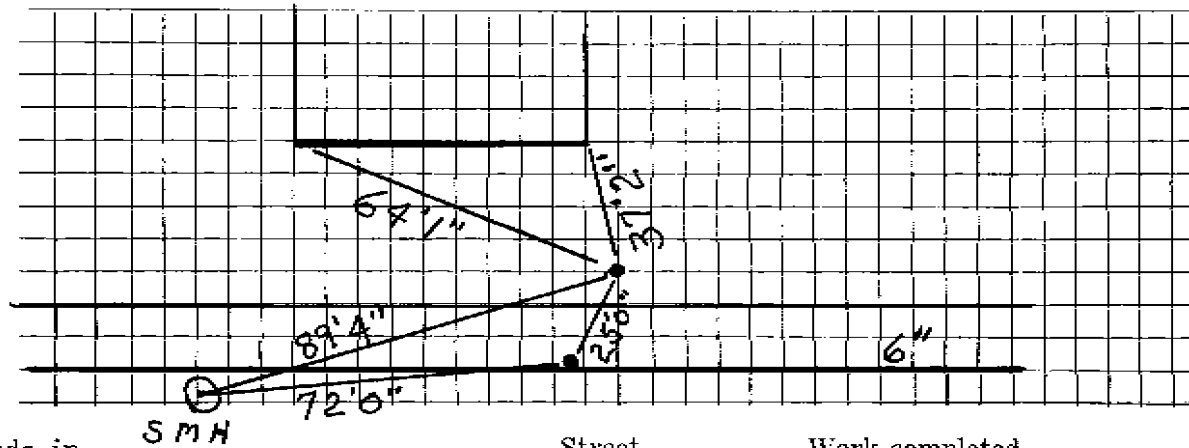

Connection made in SMH Street.

Work completed19

Remarks: