

## WATER SERVICE RECORD

Name William L. Potter

Service No. 50

Address 15 Downing Rd.

Location

~~Repair & Renewal~~ New Service


Comm 7-5-60

Date	Material	Amount	Total	Date	Amount	
5-16-60	Labor	1.69		4-25-60	Deposit	50 00
	10 % O.H.	.17	1 86	7-5-60	Refund	24 33
42'	3/4" Copper tubing @.42		17 64			25 67
1	3/4" 2x1/2 I.W.H. Stop & Waste		6 17		MON CHARGE	
			25 67		Labor	1 61
				25'	3/4" Copper tubing @.42	10 50
				1	3/4" C Corp Cock	4 91
				1	3/4" C Curb Cock	6 28
				1	Box & Rod	5 00
				1	1/2" Straight tailpiece	50
				1	1/2" Offset tailpiece	50
						29 30

TOWN OF LEXINGTON — BOARD OF PUBLIC WORKS

WATER DIVISION

Sketch of Service Here

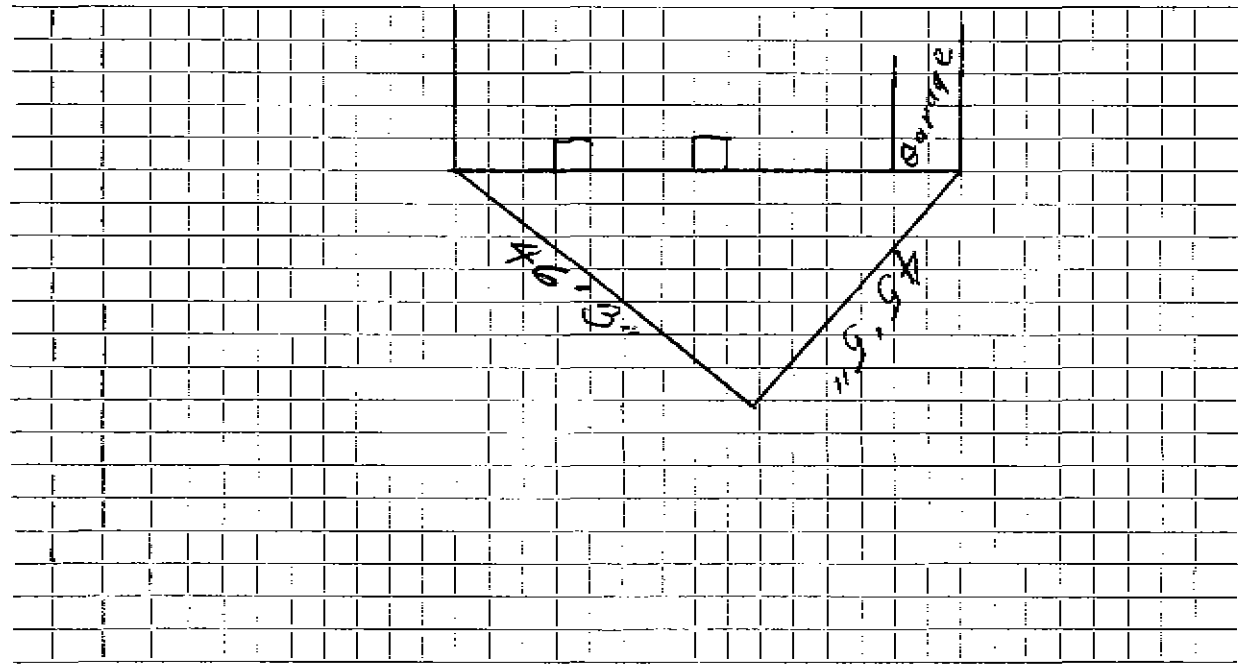

Connection made in ..... Street. Work completed .....

Remarks: ..... 46' 3" Could be 40' 3" Tie from Job Not Clear .....

.....  
.....