


WATER SERVICE RECORD

Service No.

#4827
#0000

Name

Address

Location  Downing Road - Lot #22 - main to curb

Repair—Renewal—New Service


install service (main to curb) W.O. #7868

Date	Material	Amount	Total	Date	Amount
7/9/70	Labor	10.50		6-16-70	
	10% O.H.	1.05	11.55	33' 3/4" Copper	
31'	3/4" Copper @ .79		24.49	1 3/4" Adapter	
	3/4" Corporatim		2.76	1 3/4" C. Curb Cock	
	3/4" Curb stop		11.32	1 1" Repair Clamp	
	Box & Rod		5.10	1 1" Coupling	
1	hr. Trucking		3.00	1 4" Nipple	
			\$ 58.22		

DATE _____

TOWN OF LEXINGTON -- BOARD OF PUBLIC WORKS
WATER DIVISION

Sketch of Service Here

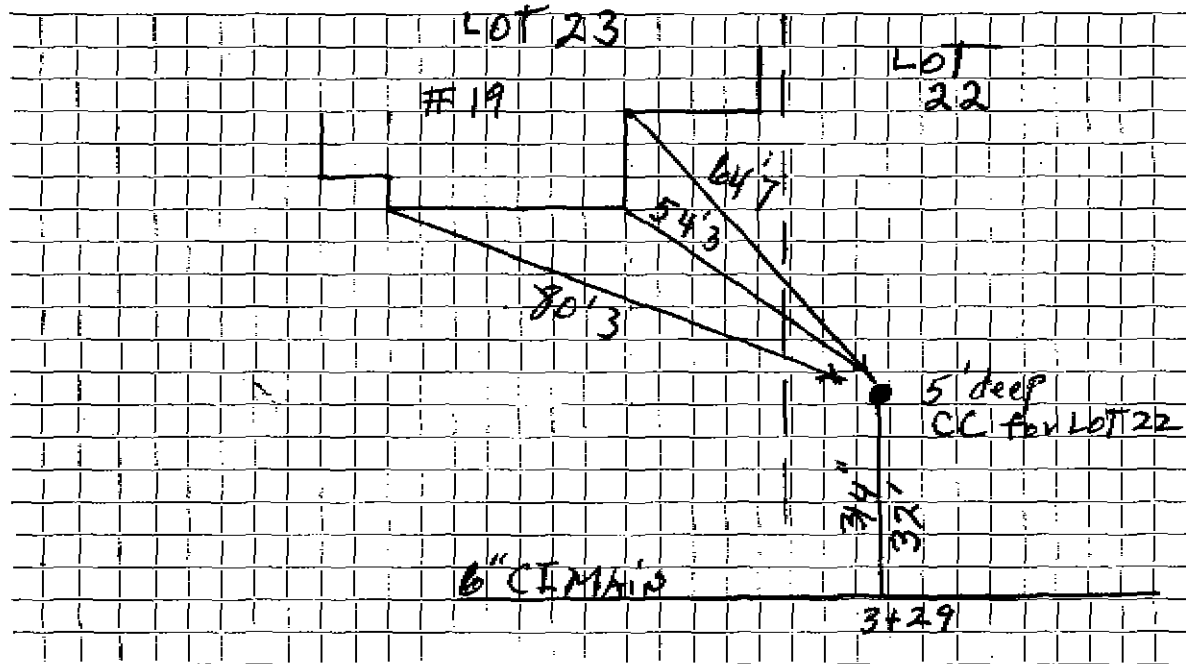

Connection made in Street. Work completed

Remarks:
.....
.....