

Name Frank Preston  
 Address 25 Downing Road  
 Lexington

Service No. 125

# 617  
 # 864

Location 25 Downing Road

Kind of Pipe Size Size of Main

~~Repair-Renewal~~-New Service

Com 9-5-50

Location

Date	Material	Amount	Total	Date	Material	Amount
June 26 '50	Labor	4 20		June 10 '50	Depleted	60 00
	10% Overhead	42	4 62			
	58' - 3/4" Copper Tubing @ 23¢		13 34			
	1 - 3/4" C x 1/2" I.W.H. S&W		3 29		No Charge	
	2 hrs. Littlefield Shovel		14 00	June 26 '50	Labor	12 00
	1 hr. Trucking		75		25' - 3/4" Copper Tubing @ 23¢	5 75
	Patching 20 x 3		20 00		1 - 3/4" C. Corp-cock	3 15
			56 00		1 - 3/4" C x 3/4" C Curb-cock	3 85
					1 Box & Rod	3 35
					1 - 1/2" Offset Tail Piece	38
					1 - 1/2" Straight Tail Piece	38
					2 hrs. Littlefield Shovel	14 00
	Labor				1 hr. Trucking	75
						43 61

DATE \_\_\_\_\_

# TOWN OF LEXINGTON—BOARD OF PUBLIC WORKS

## WATER DIVISION

The undersigned applies for a supply of water at No. \_\_\_\_\_ St. and hereby agrees to comply with the rules and regulations as now, or at any future time, established by the Board of Selectmen.

Am't. of Estimate \$ \_\_\_\_\_


Owner \_\_\_\_\_

Am't. Paid \$ \_\_\_\_\_

Address \_\_\_\_\_

Builder \_\_\_\_\_

Sketch of Service Here

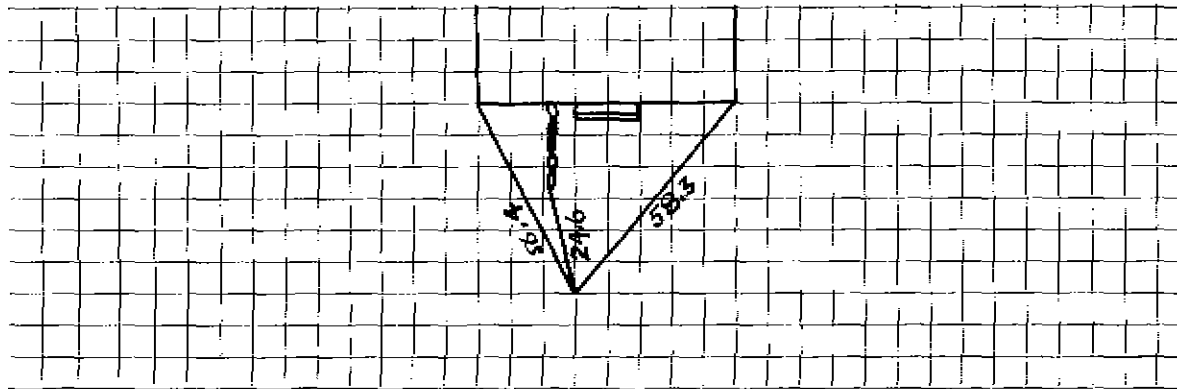

Connection made in \_\_\_\_\_ Street.

Work completed \_\_\_\_\_ 19

Remarks: