

Name John C. Crocker

#8740

Service No. ~~30~~ 744

#1721

#7700

Address 2 Norumbega Terrace, Waltham, Mass.

26 Downing Rd.

#26

Location Lot 191 Downing Road

Kind of Pipe

Size

Size of Main

~~Repair-Renewal~~ - New Service

Location

Date	Material	Amount	Total	Date	Amount
1938					
Aug. 18,	2 hrs. @ 80¢	1 20	1 20	August 9, 1938 Deposited	27 50
Aug. 17 38	44' 3/4" Cop. Tubing @ 20¢		8 80		
	1 3/4" C.S. & L.		3 75		
	1 3/4" Bushing		30		
	Trucking- 2 hrs. @ 75¢		1 50		
			<u>15 55</u>		
	<u>Flat Rate:</u>				
	44' @ 50¢		22 00		
	French Repairs		5 50		
			<u>27 50</u>		
	<b>Labor</b>				

Hadley Press, Inc., Lexington

DATE \_\_\_\_\_

# TOWN OF LEXINGTON—BOARD OF PUBLIC WORKS

## WATER DIVISION

The undersigned applies for a supply of water at No. Downing Rd. St. and hereby agrees to comply with the rules and regulations as now, or at any future time, established by the Board of Selectmen.

Am't. of Estimate \$ 27.50


Owner John C. Crocker

Am't. Paid \$ \_\_\_\_\_

Address 2 Norumbega Ter.  
Waltham

Builder John C. Crocker

Sketch of Service Here

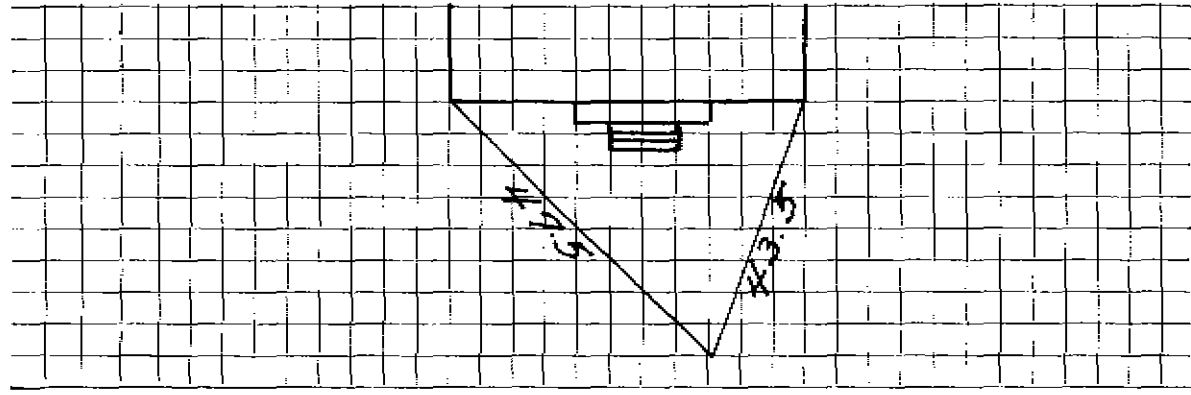

Connection made in \_\_\_\_\_ Street.

Work completed \_\_\_\_\_ 19

Remarks: