

WATER SERVICE RECORD

Name Ted Freeman ; 23 Washington Drive; Acton

Service No. 38

Address 27 Downing Road

Location

~~Repair~~ ~~Renewal~~ New Service W.O. #2700

*Egg/r #2595*

FEB 10 1975


Date	Material	Amount	Total	Date	Amount
11-13-74	Labor	20.12		1-1-75	150.00
	10 % O.H.	2.01	\$22.13	3-11-75	46.79
33'	3/4" Copper Pipe	@1.05	34.65		83.31
1	3/4" Corporation		10.53		
1	3/4" Curb Stop		12.45		
1	Box and Rod		12.95		
			\$83.21		

DATE \_\_\_\_\_

TOWN OF LEXINGTON — BOARD OF PUBLIC WORKS

WATER DIVISION

Sketch of Service Here

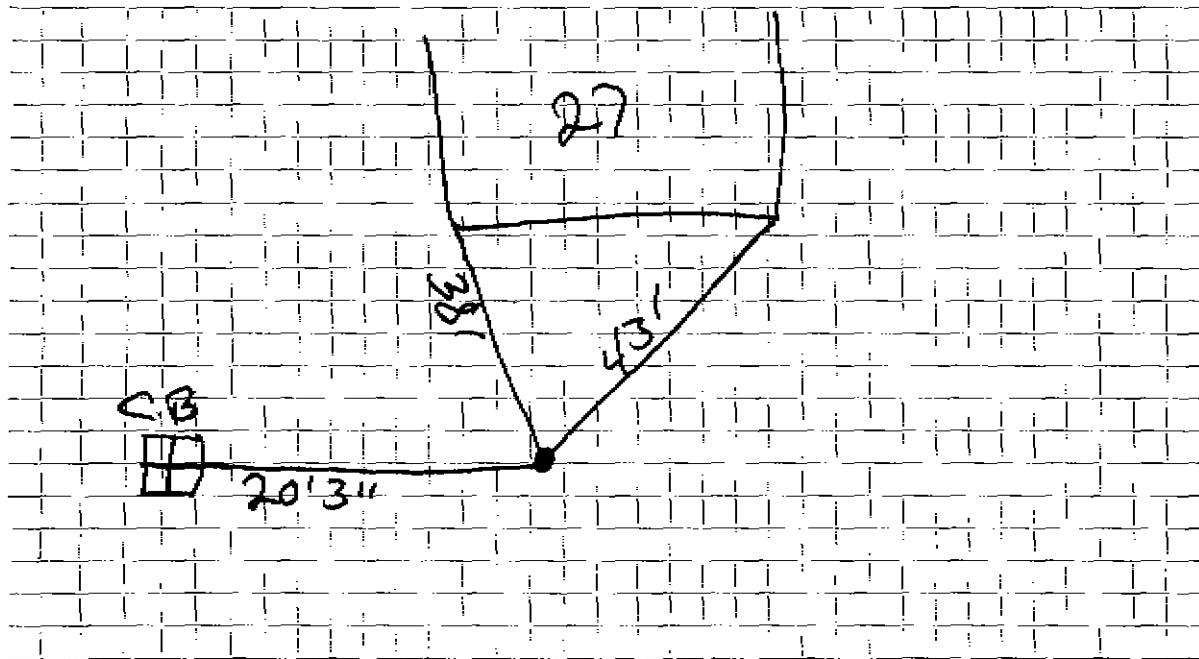

Connection made in ..... Street. Work completed .....

Remarks: .....

.....

.....