

WATER SERVICE RECORD

Name

Service No.

Address 32 Downing Road

Location main to curb

~~Repair~~—Renewal—~~New Service~~ W.O. # 7862


Date	Material	Amount	Total	Date	Amount
8-4-31	38' 1' C.L. Pipe				
				** OUTSIDE	
				6/17/70	Labor 58.12
				9'	3/4" Copper pipe @ .79 7.11
				1	3/4" Adaptor 2.76
				1	3/4" Curb cock 11.32
				1	1" Coupling .60
				1	1" x 4" .54
				1	1" Repair clamp 5.05
				1	hr. Trucking 3.00
				2	hrs. Shovel @ 4.00 8.00
					<u>96.50</u>

DATE _____

TOWN OF LEXINGTON BOARD OF PUBLIC WORKS

WATER DIVISION

Sketch of Service Here

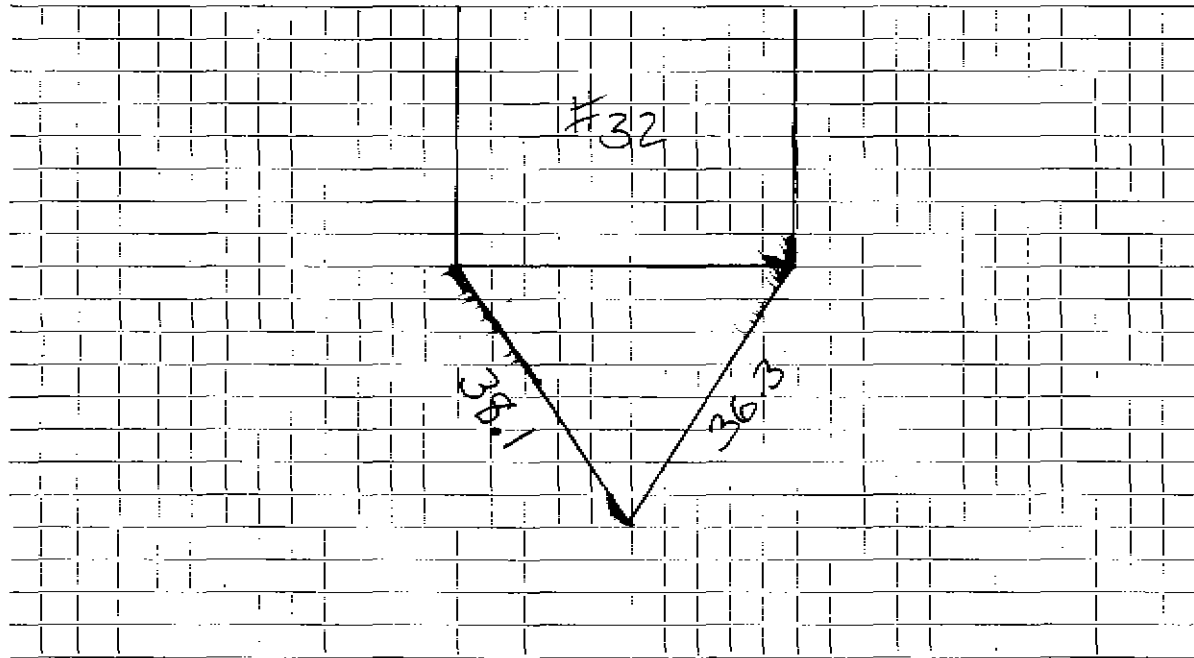

Connection made in Street. Work completed

Remarks:
.....
.....