

#8757

## WATER SERVICE RECORD

Service No. 139

#949  
#6391

Name Clayton Oban

Address 37 Downing Road

Location

~~Repair~~ - ~~Renewal~~ - ~~New Service~~ W.O.#9344

FEB 15 1965


Date	Material	Amount	Total	Date	Amount
12-11-64	Labor 106.08			11-3-64	Deposit 125.10
12-14-64	Labor 9.05	115.13			
	10% O.H.	11.51	126.64		
35'	3/4" Copper tubing @ .42		14.70		
1	3/4 x 1/2 Compressor Valve		9.29		
1	3/4" - 3 Part Union		3.01		
	20 x 3 Patch		20.00		
				27'	3/4" Copper tubing @ .42 11.34
1	Hr. Town Shovel		6.50	1	3/4" Corp Cock 7.41
1	Hr. Town Truck		3.00	1	3/4" Curb Cock 8.76
			183.14	1	Box & Rod 4.90
				1	1/2" Offset 5.00
				1	1/2" Strait tailpiece 5.00
				1	Hr. Town Shovel 6.50
				1	Hr. Town Truck 3.00
					42.91
					Bill sent 58.14

DATE \_\_\_\_\_

TOWN OF LEXINGTON — BOARD OF PUBLIC WORKS

**WATER DIVISION**

Sketch of Service Here

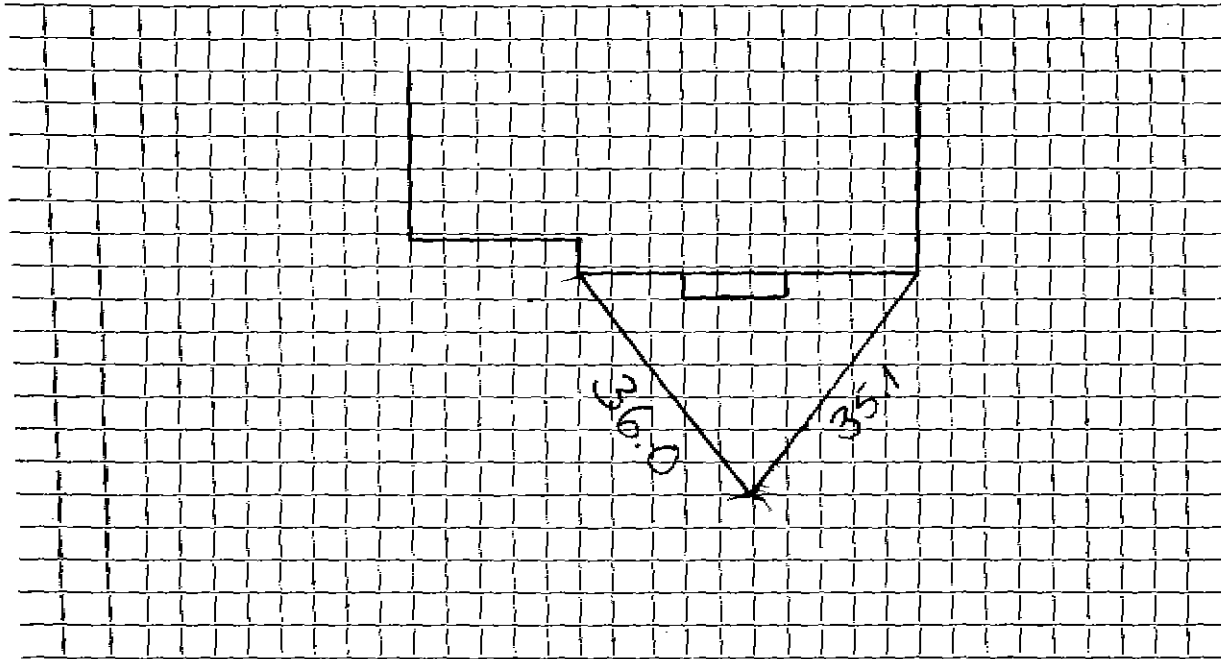

Connection made in ..... Street. Work completed .....

Remarks: .....

.....  
.....