

Name Arthur Mitchell  
Address 38 Downing Road  
Lexington, Mass.

Location 38 Downing Road

Kind of Pipe Size Size of Main  
~~Repair~~ ~~Reconnect~~ - New Service Com. 6-14-49 Location

Date	Material	Amount	Total	Date	Amount
May 3, '49	Labor	2 35	2 35	<i>April 22 49</i>	<i>Deposited</i> 40 00
	10% Overhead		24	<i>June 24 49</i>	<i>Refunded</i> 14 72
	38' - 3/4" Copper Tubing @.27	10 26			Non-Charge 25 28
	1 - 3/4" C x 1/2" I.W.H. S&W	3 29		May 3, '49	Labor 2 35
	1 - 3/4" C x 3/4" C Union (pts)	1 39		9' - 3/4" Copper tubing @.27	2 43
	Littlefield Shovel 1 hr. @ 7.00	7 00		1 - 3/4" C Corp-cock	3 15
	Trucking 1 hr. @.75		75	1 - 3/4" C x 3/4" C Curb-cock	3 85
			25 28	1 - Box & Rod	3 95
<i>12/20/55</i>	<i>2' - 3/4" copper</i>			1 - 1/2" Straight Tail Piece	37
	<i>1 - 3/4" union</i>			1 - 1/2" Offset Tail Piece	37
				Littlefield Shovel 1 hr. @ 7.00	7 00
	Labor			Trucking 1 hr. @.75	75
					<hr/> 24 22

TOWN OF LEXINGTON - BOARD OF PUBLIC WORKS

**WATER DIVISION**

The undersigned applies for a supply of water at No..... St. and hereby agrees to comply with the rules and regulations as now, or at any future time, established by the Board of Selectmen.

Am't of Estimate \$.....


Owner .....

Am't Paid \$.....

Address .....

Builder .....

Sketch of Service Here

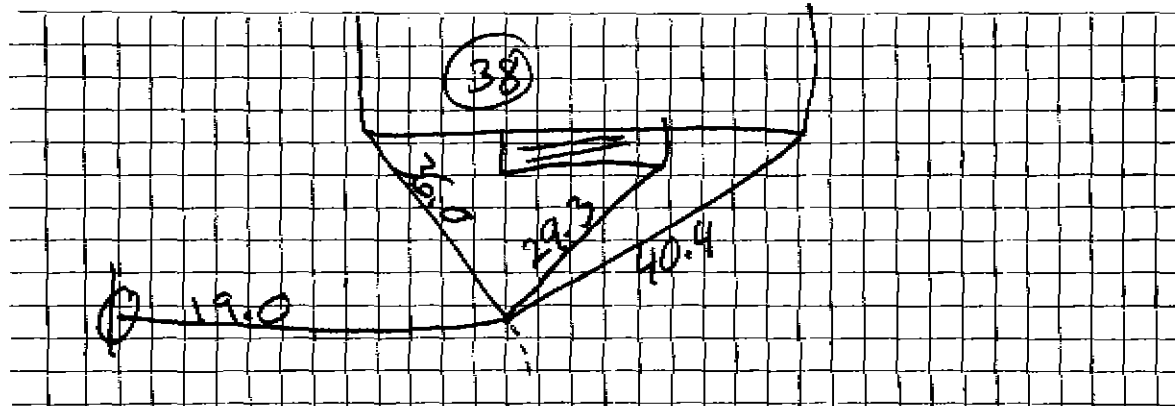

Connection made in ..... Street.

Work completed .....19

Remarks: main tapped on top steel gas main next to the water main  
house side water 0 892