

Name Arthur Mitchell

Service No.

Address 39 Downing Road

3112

Lexington, Mass.

Location 39 Downing Road

Kind of Pipe

Size

Size of Main

~~Repair-Overhaul~~ New Service

Com. 6-14-49

Location

Date	Material	Amount	Total	Date	Material	Amount
May 7, '49	Labor	4 74	4 74	April 22 '49	Deposited	40 00
	10% Overhead		47	June 24 '49	Refunded	13 49
	38' - 3/4" Copper Tubing @.27	10 26			Non-Charge	26 51
	1 - 3/4" C x 1/2" I.W.H. S&W	3 29		May 7, '49	Labor	4 73
	Littlefield Shovel 1 hr. @7.00	7 00			26' - 3/4" Copper Tubing @.27	7 02
	Trucking 1 hr. @.75	75			1 - 3/4" C Corp-cock	3 15
			26 51		1 - 3/4" C x 3/4" C Curb-cock	3 85
					1 - Box & Rod	3 95
					1 - 1/2" Straight Tail Piece	37
					1 - 1/2" Offset Tail Piece	37
					Littlefield Shovel 1 hr. @ 7.00	7 00
					Trucking 1 hr. @.75	75
	Labor					31 19

DATE \_\_\_\_\_

TOWN OF LEXINGTON - BOARD OF PUBLIC WORKS

**WATER DIVISION**

The undersigned applies for a supply of water at No..... St. and hereby agrees to comply with the rules and regulations as now, or at any future time, established by the Board of Selectmen.

Am't of Estimate \$.....

Owner .....


Am't Paid \$.....

Address .....

Builder .....

.....

Sketch of Service Here

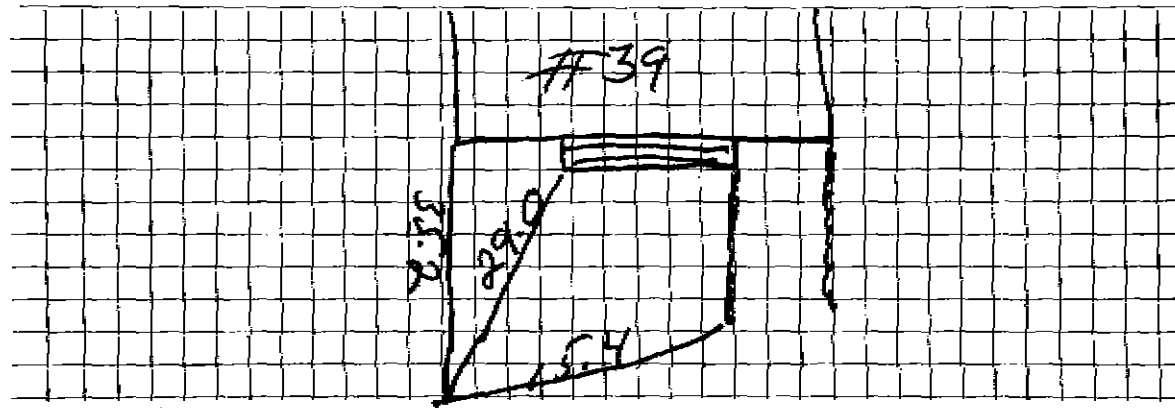

Connection made in ..... Street.

Work completed .....19

Remarks: