

Name Arthur Mitchell

Service No. 126

Address 40 Downing Road

Location 40 Downing Road

Kind of Pipe

Size

Size of Main

~~Repair~~ ~~Renewal~~ New Service

Com. 8-15-49

Location

Date

Material

Amount

Total

Date

Amount

June 18, '49

Labor

5 30

5 30

10% Overhead

54

35' - 3/4" Copper tubing @.24

8 40

1 - 3/4" C x 1/2" I.W.H. S&W

3 29

1 1/2 hrs. Littlefield Shovel

10 50

Trucking 1 hr. @.75

75

28 78

June 14, '49 Deposited

40 00

Non-Charge

28 78

June 20, '49

Labor

3 55

10' - 3/4" Copper Tubing @.24

2 40

1 - 3/4" C Corp-cock

3 15

1 - 3/4" C x 3/4" C Curb-cock

3 85

1 - Box & Rod

3 95

1 - 1/2" Offset Tail Piece

37

1 - 1/2" Straight Tail Piece

37

Littlefield Shovel 1 hr.

7 00

Trucking 1 hr.

75

Labor

25 39

DATE _____

TOWN OF LEXINGTON - BOARD OF PUBLIC WORKS

WATER DIVISION

The undersigned applies for a supply of water at No..... St. and hereby agrees to comply with the rules and regulations as now, or at any future time, established by the Board of Selectmen.

Am't of Estimate \$.....

Owner


Am't Paid \$.....

Address

Builder

.....

Sketch of Service Here

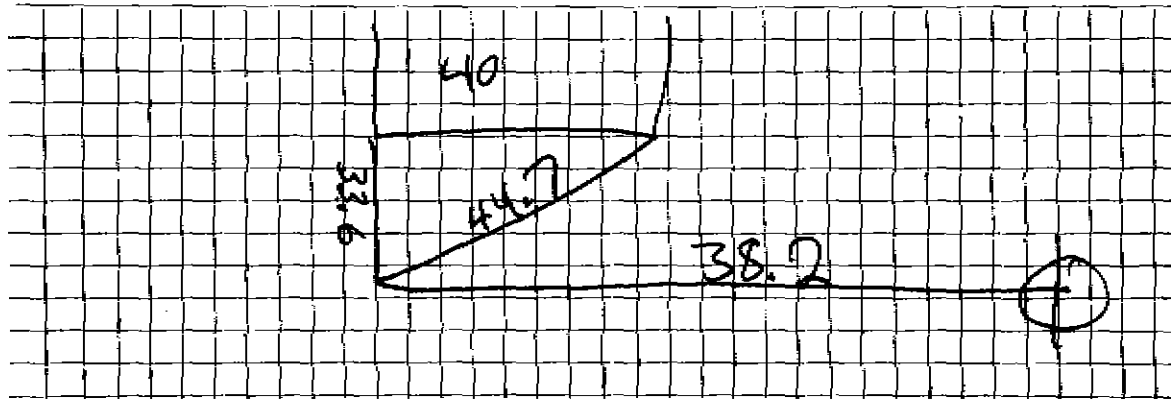

Connection made in Street.

Work completed19

Remarks: 