

WATER SERVICE RECORD

Name Ted Freeman

Service No. 12

Address

Location 44 Downing Rd. - Lot #184

Repair—Renewal—New Service install service main to curb - W.O #7874 Eagle #2489

AUG 16 1976


Date	Material	Amount	Total	Date	Amount
7/7/70	Labor	12.50		5-55-74	Deposit
	10% O.H.	1.25	13.75		49.79
24'	3/4" Copper @ .79		18.96		
	3/4" Corporation		2.76		
	3/4" Curb stop		11.32		
	Box & rod		5.10		
1	hr. Trucking		3.00		
			\$ 49.79		
6/5/74	37' 3/4" Copper Tubing				

DATE _____

TOWN OF LEXINGTON — BOARD OF PUBLIC WORKS

WATER DIVISION

Sketch of Service Here

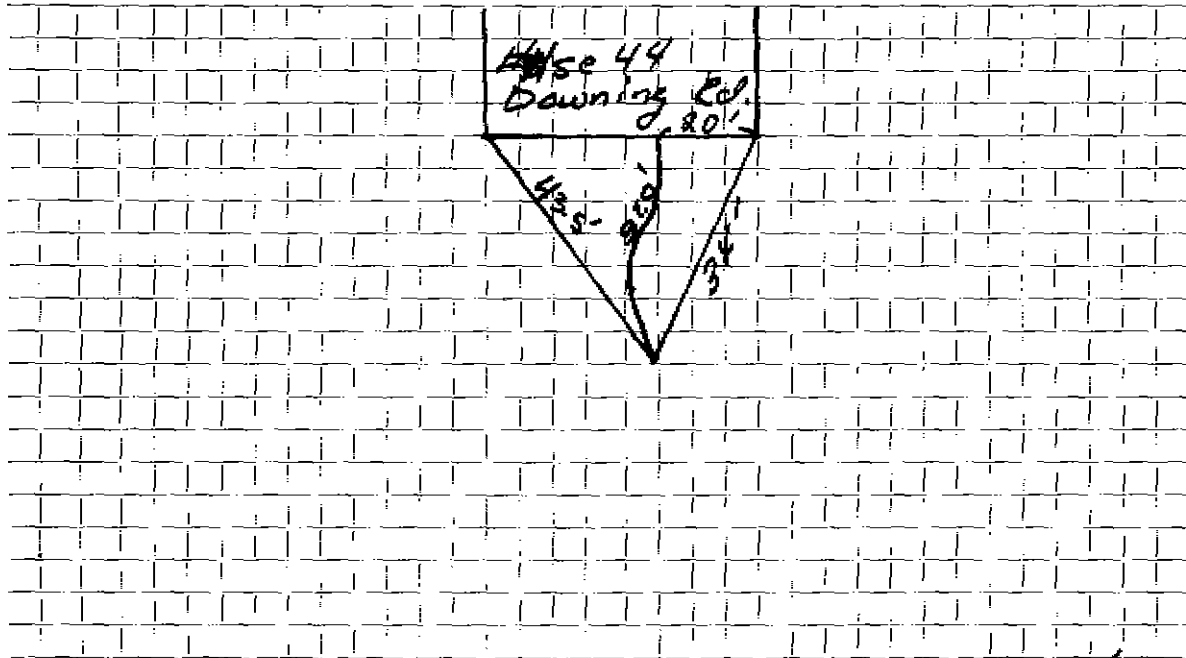

Connection made in ... Downing Rd. Street. Work completed ... 6/5/74

Remarks:
.....
.....