

Name Arthur Mitchell

Service No.

107  
#4734

Address 47 Downing Road

Location 47 Downing Road

Kind of Pipe

Size

Size of Main

~~Repair - Renewal~~ - New Service

Com. 8-15-49

Location

Date	Material	Amount	Total	Date	Amount
June 18, 49	Labor	5 35	5 35	June 14, 49	75 00
	10% Overhead		54	Aug 25 49	70 46
	36' - 3/4" Copper Tubing @.24		8 64	<i>Deposited</i> <i>Received</i> Non-Charge	
	1 - 3/4" C x 1/2" I.W.H. S&W		3 29	June 20, '49	Labor
	1 - 3/4" C x 3/4" C Union		1 39	55' - 3/4" Copper Tubing @.24	13 20
	Littlefield Shovel 1 1/2 hrs.		10 50	1 - 3/4" C Corp-cock	3 15
	Trucking 1 hr.		75	1 - 3/4" C x 3/4" C Curb-cock	3 85
	Patching 40 x 3		40 00	1 - Box & Rod	3 95
			70 46	1 - 1/2" Offset Tail Piece	37
				1 - 1/2" Straight Tail Piece	37
				2 - 3/4" C x 3/4" C Union	2 78
				Littlefield Shovel 3 1/2 hrs.	24 50
	Labor			Trucking 1 hr.	75
					65 94

DATE \_\_\_\_\_

TOWN OF LEXINGTON - BOARD OF PUBLIC WORKS

**WATER DIVISION**

The undersigned applies for a supply of water at No..... St. and hereby agrees to comply with the rules and regulations as now, or at any future time, established by the Board of Selectmen.

Am't of Estimate \$.....

Owner .....


Am't Paid \$.....

Address .....

Builder .....

.....

Sketch of Service Here

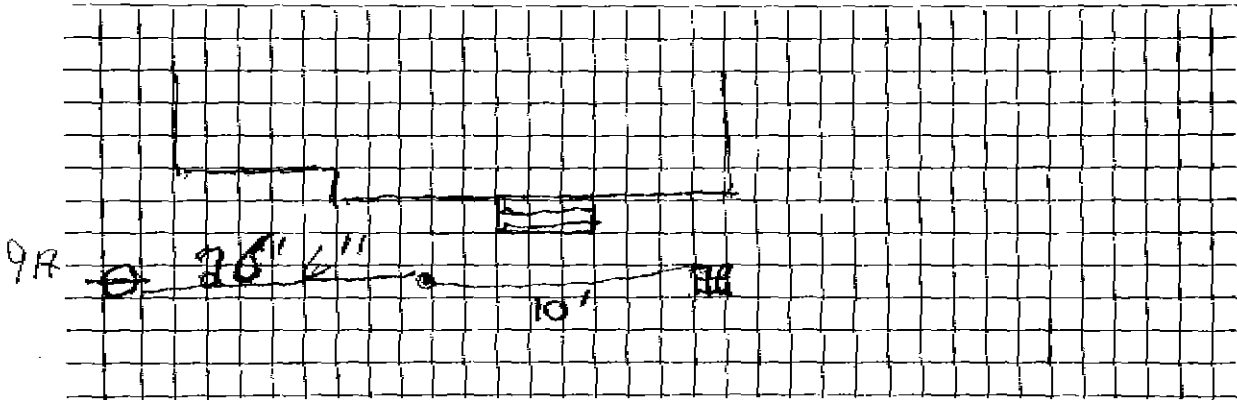

Connection made in ..... Street.

Work completed .....19

Remarks: