

Andrew Deveau

Service No.

90 #4269
3312

49 Downing Road

Lexington, Mass.

Location 49 Downing Road

of Pipe

Size

Size of Main

~~Renewal~~—New Service

Location

Material	Amount	Total	Date	Amount
47 Labor	1 05	1 05	July 23 '47	50 00
10% Overhead		11	Sept 25 '47	1 86
42' - 3/4" Copper Tubing @.28		11 76		48 14
1 - 3/4" C x 1/2" I.W.H. S & W		3 15	Jul. 25, '47 Labor	49 30
1 - 3/4" C x 3/4" C Union (3pts)		1 32	87' - 3/4" Copper Tubing @.28	24 36
Patching 30 x 3		30 00	1 - 3/4" C Corp-cock	3 00
Trucking 1 hr. @.75		75	1 - 3/4" C x 3/4" C Curb-cock	3 68
		48 14	2 - 3/4" C x 3/4" C Union (3pts)	2 64
			1 - Box & Rod	4 26
			1 - 1/4" Offset Tail Piece	30
			1 - 1/2" Straight Tail Piece	30
			Trucking 1 hr. @.75	75
Labor				<u>88 59</u>

Deposited
Refunded
Non-Charge

DATE _____

TOWN OF LEXINGTON - BOARD OF PUBLIC WORKS

WATER DIVISION

The undersigned applies for a supply of water at No. St. and hereby agrees to comply with the rules and regulations as now, or at any future time, established by the Board of Selectmen.

Cost of Estimate \$.....

Owner


Paid \$.....

Address *81 South Main St*

.....

.....

Sketch of Service Here

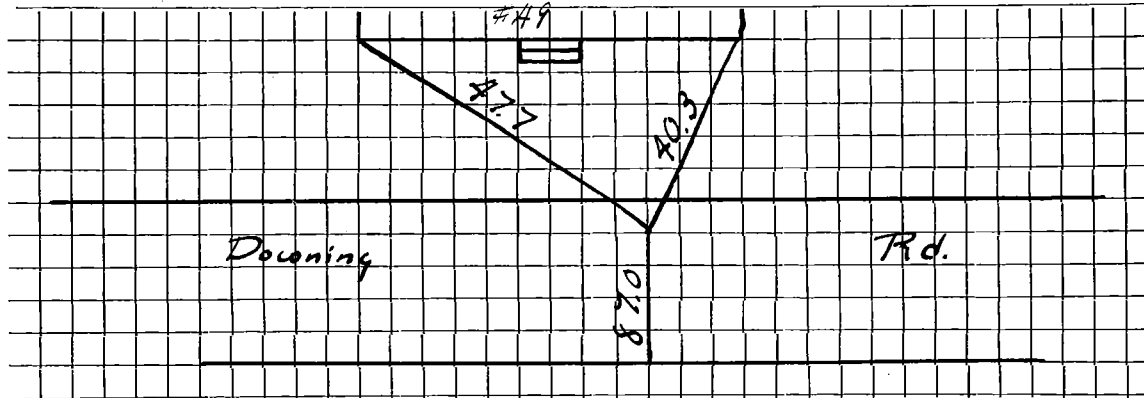

Work made in Street.

Work completed19

Works: