

WATER SERVICE RECORD

Service No.

2718

Name

Address

Location ✓ Downing Road - Lot #19

Repair—Renewal—New Service install service - W.O. #7866


Date	Material	Amount	Total	Date	Amount
7/7/70	Labor	12.50			
	10% O.H.	1.25	13.75		
39'	3/4" Copper @ .79		30.81		
	3/4" Corporation		2.76		
	3/4" Curb stop		11.32		
	Box & rod		5.10		
1	hr. Trucking		3.00		
			\$ 66.74		
June 20 (1941)	71' 1" Copper Tubing				
	1" C x 3/4 I.S. & W.				

DATE _____

TOWN OF LEXINGTON -- BOARD OF PUBLIC WORKS

WATER DIVISION

Sketch of Service Here

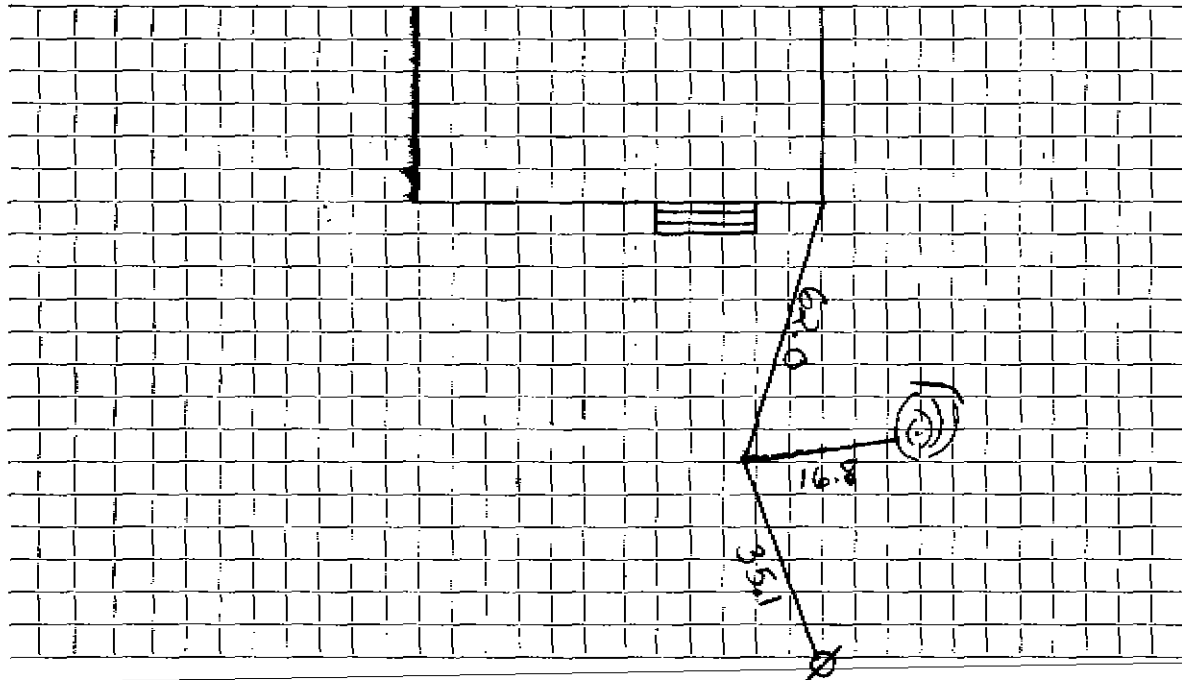

Connection made in Street. Work completed

Remarks:

.....
.....