

Name Ferry, Manuel

Service No. ~~25~~ 751 ⁷⁹

Address 1775 Mass. Ave., Lexington

50 Downing Road

Location

#33
Cor. Downing Road

Kind of Pipe

Size

Size of Main

~~Repair~~ ~~Renewal~~ — New Service

Location

Date	Material	Amount	Total	Date	Amount
1936 7/14 <i>Comm. 7-21-36 \$32.40</i>	16 hrs. labor @ 55¢	8 80		July 14, 1936	Deposited 44 00
	20 " " @ 60¢	<u>12 00</u>	20 80	July 21, 1936	Refunded 22 60
	10% Ovhd. on labor @ 18¢		2 08		32 40
	39' 3/4" Copper Tub.	7 02			
	1 Stop & Waste	1 75			
	Trucking	<u>75</u>	<u>9 52</u>		
			<u>32 40</u>		
	Labor				

DATE _____

TOWN OF LEXINGTON—BOARD OF PUBLIC WORKS

WATER DIVISION

The undersigned applies for a supply of water at No. _____ St. and hereby agrees to comply with the rules and regulations as now, or at any future time, established by the Board of Selectmen.

Am't. of Estimate \$ _____


Owner _____

Am't. Paid \$ _____

Address _____

Builder _____

Sketch of Service Here

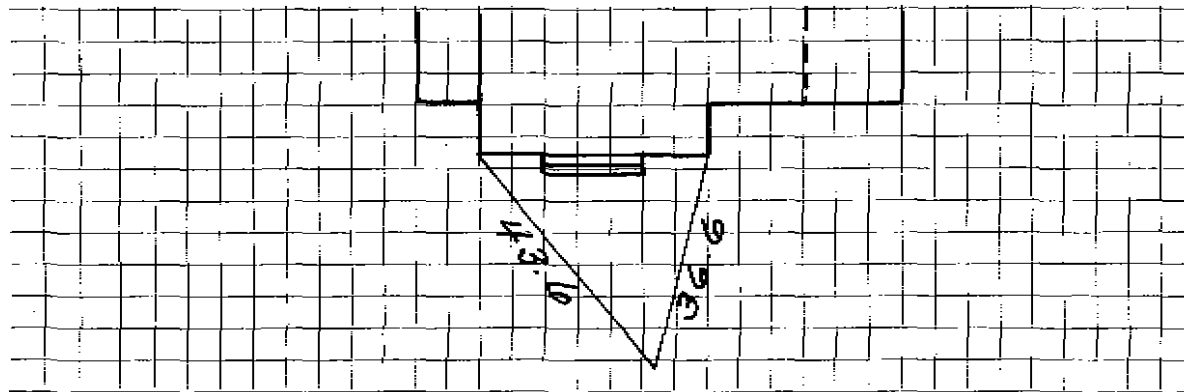

Connection made in _____ Street.

Work completed _____ 19

Remarks: