

Name Andrew Deveau

Service No.

no #4269
8812

Address 49 Downing Road

Lexington, Mass.

Location 49 Downing Road

Kind of Pipe

Size

Size of Main

~~Repair~~ ~~Renewal~~ ~~New Service~~

Location

Date	Material	Amount	Total	Date	Amount
Jul. 25, '47	Labor	1 05	1 05	July 25 '47	50 00
	10% Overhead		11	Sept 25 '47	1 50
	42' - 3/4" Copper Tubing @ .28		11 76		48 14
	1 - 3/2" C x 3/4" T.W.K. S & W		3 16	Jul. 25, '47	49 30
	1 - 3/4" C x 3/4" C Union (3pts)		1 30	87' - 3/4" Copper Tubing @ .28	24 36
	Patching 30 x 3		30 00	1 - 3/4" C Corp-cock	3 00
	Trucking 1 hr. @ .75		75	1 - 3/4" C x 3/4" C Curb-cock	3 68
			48 14	2 - 3/4" C x 3/4" C Union (3pts)	2 64
				1 - Box & Rod	4 25
				2 - 2" Offset Tail Piece	30
				2 - 2" Straight Tail Piece	30
				Trucking 1 hr. @ .75	75
	Labor				88 50

Deposited
Refunded
Non-Charge

DATE _____

TOWN OF LEXINGTON - BOARD OF PUBLIC WORKS

WATER DIVISION

The undersigned applies for a supply of water at No. St. and hereby agrees to comply with the rules and regulations as now, or at any future time, established by the Board of Selectmen.

Am't of Estimate \$.....

Owner


Am't Paid \$.....

Address *80 Downing Rd.*

Builder

.....

Sketch of Service Here

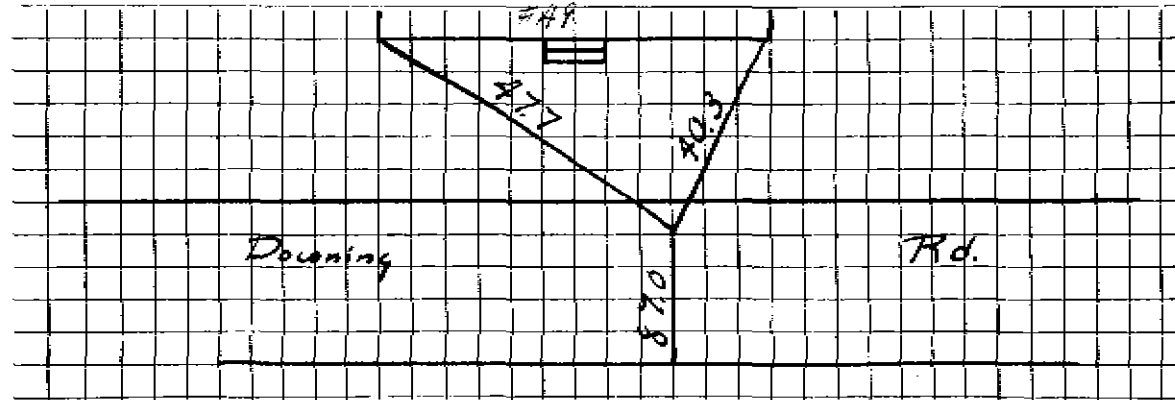

Connection made in Street.

Work completed19

Remarks: