

WATER SERVICE RECORD

1422 #5984

Name Robert Findlay

Service No. 105

Address 11 Drew Ave.

Location Lexington

Lot 59-64

Repair—Renewal—~~NEW SERVICE~~

Derive #1718

am 7-13-53


Date	Material	Amount	Total	Date	Amount
6/11/53	Labor	9 33		5-20-53 Deposited	75 00
	10% overhead	93	10 26	7-13-53 Re-funded	6 17
	80' -3/4" Copper Tubing @.37		29 60		NON CHARGE 68 83
	1-3/4" C x 1/2 I.W.H. STOP & WASTE	1 00		6/11/53 Labor	9 34
	1-3/4" C x 3/4" C. Union(3 parts)	1 72		18' -3/4" Copper Tubing @.37	6 66
	3 Hrs. Littlefield Shovel @7.50	22 50		1-3/4" C. Curb-cock	4 33
	1 Hr. Trucking	75		1-3/4" C x 3/4" C. Curb-cock	4 67
			68 83	1-Rox & Rod	3 90
8-31-70	63' 3/4" Copper tubing			1-1/2 offset tail piece	50
				1-1/2 straight tail piece	50
				2 Hr. Littlefield Shovel 7.50	15 00
				1 Hr. Trucking	75
				Patching 10 x 3	10 00
					55 75

DATE \_\_\_\_\_

TOWN OF LEXINGTON — BOARD OF PUBLIC WORKS

WATER DIVISION

Sketch of Service Here

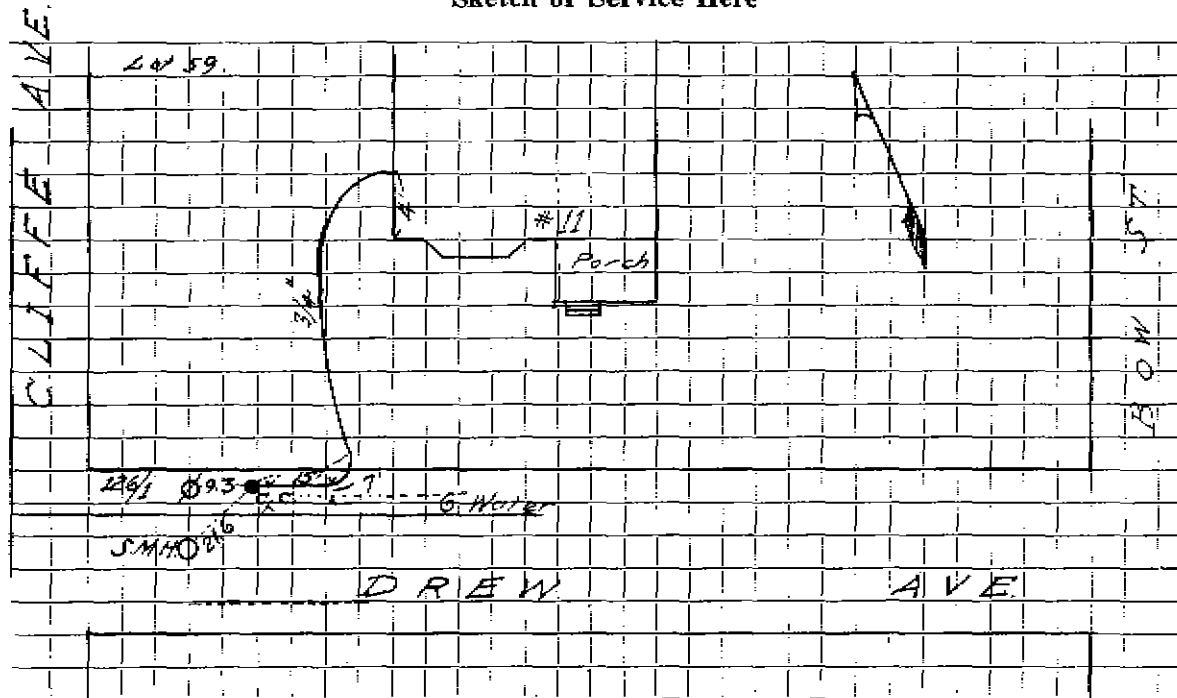

Connection made in ..... Street. Work completed .....

Remarks: .....

.....

.....