

WATER SERVICE RECORD

1345 1384

Service No.

29 of 34

Name Donna Realty Trust

Address 15 Drew Avenue

Location Lots 59 & 60 Sta. 2+30 Right
Office #1718

Repair—Renewal—New Service Valeri #1619

SEP 2 1 1970


Date	Material	Amount	Total	Date	Amount
7/23/70	42' 3/4" Copper tubing			6-29-70	Deposit 150.00
8-31-70	63' 3/4" Copper tubing			9-21-70	Returned 123.22
					36.78
					NON CHARGE
				8-26-68	Labor 4.39
				15'	3/4" Copper tubing @ .42 6.30
				1	3/4" C Corp Cock 4.91
				1	3/4" C Curb Cock 6.28
				1	Box & Rod 4.90
					26.78

DATE _____

TOWN OF LEXINGTON — BOARD OF PUBLIC WORKS

WATER DIVISION

Sketch of Service Here

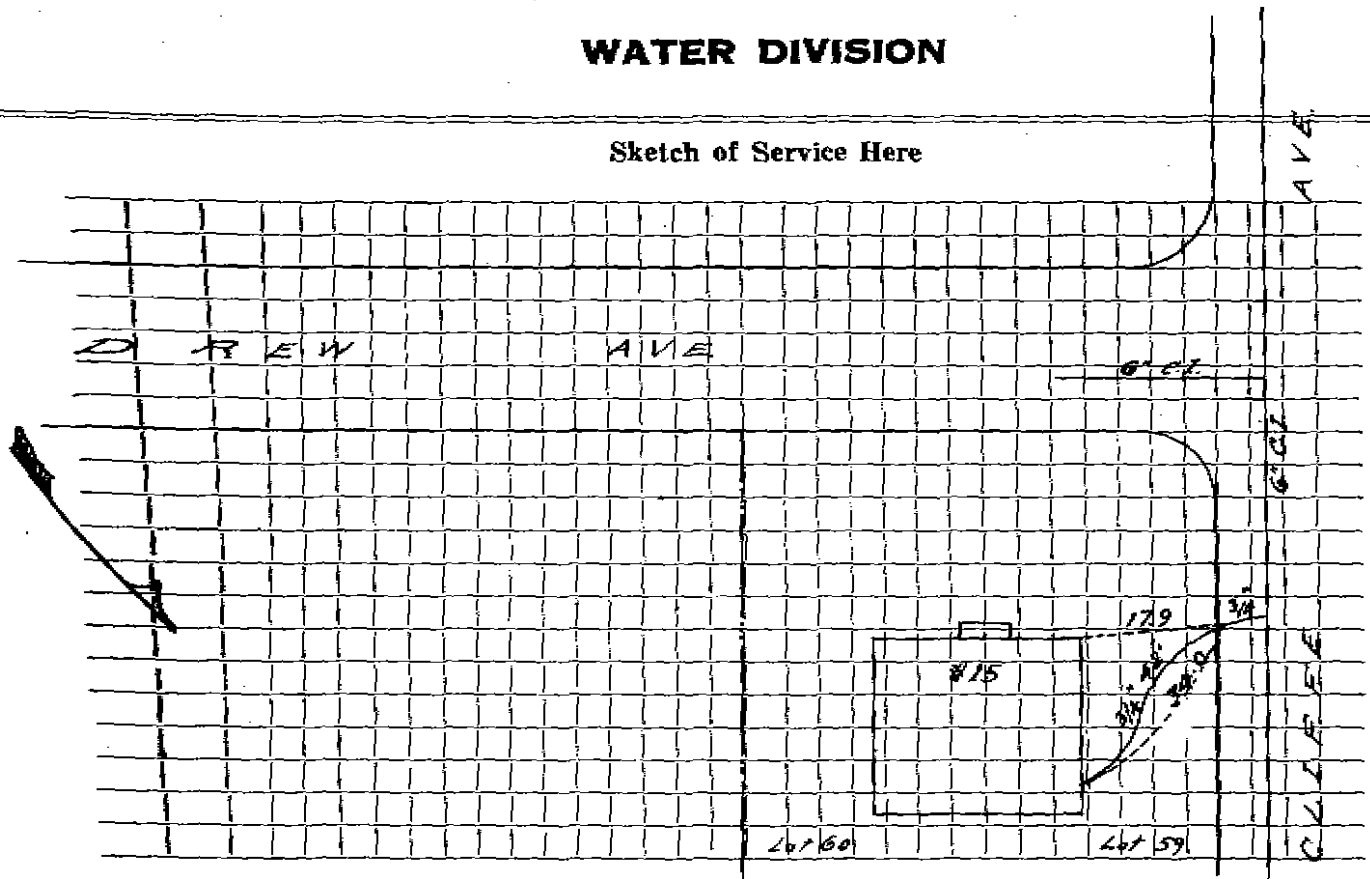

Connection made in _____ Street. Work completed _____

Remarks: See Sewer Card for ties

.....
.....