

WATER SERVICE RECORD

# 1681

Name Edward Tocio

Service No. 70

Address 5 Drew Avenue

Location

~~Renewal~~ New Service

WO #7341

Comm 7-16-62


Date	Material	Amount	Total	Date	Amount
6/8/62	Labor	2 13		6-6-62	50 00
	10% O.H.	21	2 34	7-6-62	24 69
40'	3/4" Copper Tubing @ .42		16 80		25 31
1	3/4" C x 1/2 I.W.H. Stop & Waste		6 17		
			25 31		
					Curb to Main
				6/8/62	Labor 1 93
					12 3/4" Copper Tubing @ .42 5 09
					1 3/4" C Corp Cock 4 91
					1 3/4" C Curb Cock 6 28
					1 Bow & Rod 4 90
					1 1/2 Straight Tailpiece 50
					1 1/2 Offset Tailpiece 50
					24 11

DATE \_\_\_\_\_

**TOWN OF LEXINGTON — BOARD OF PUBLIC WORKS**

**WATER DIVISION**

Sketch of Service Here

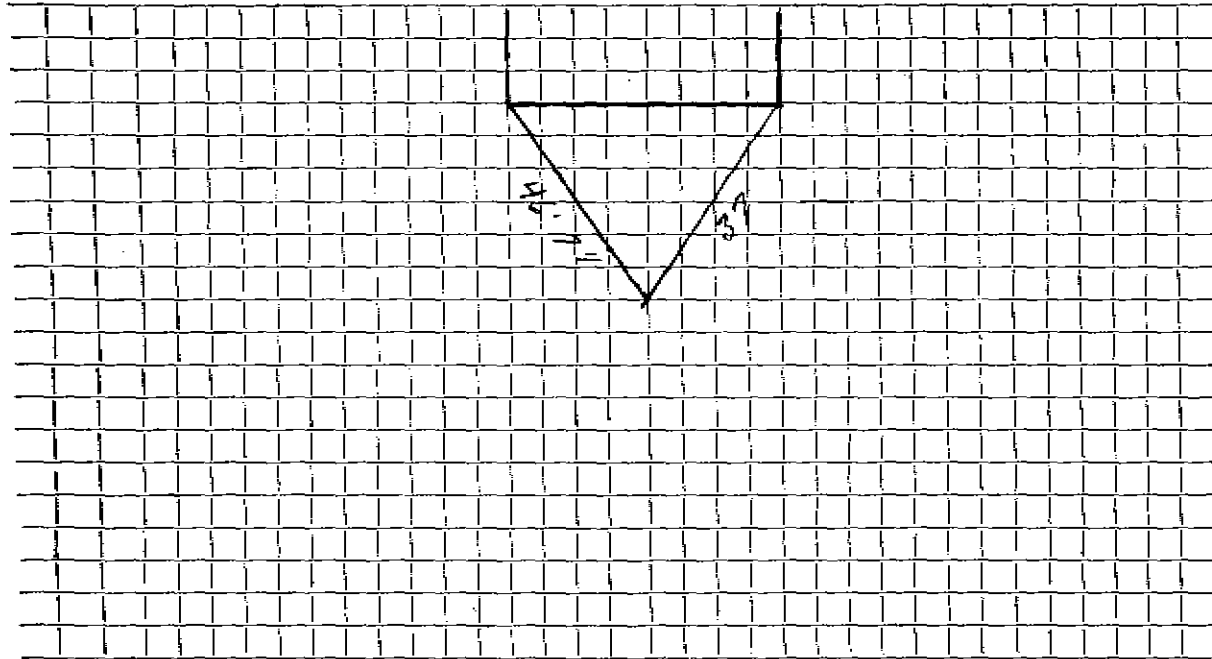

Connection made in ..... Street. Work completed .....

Remarks: .....

.....  
.....