

WATER SERVICE RECORD

#4978

Name Duffy Bros.

Service No.

Address 15 Dudley Road


Location Lot #227

Repair—Renewal—New Service

Bonanne #1398 & 1411

Remarks:

Connection made in

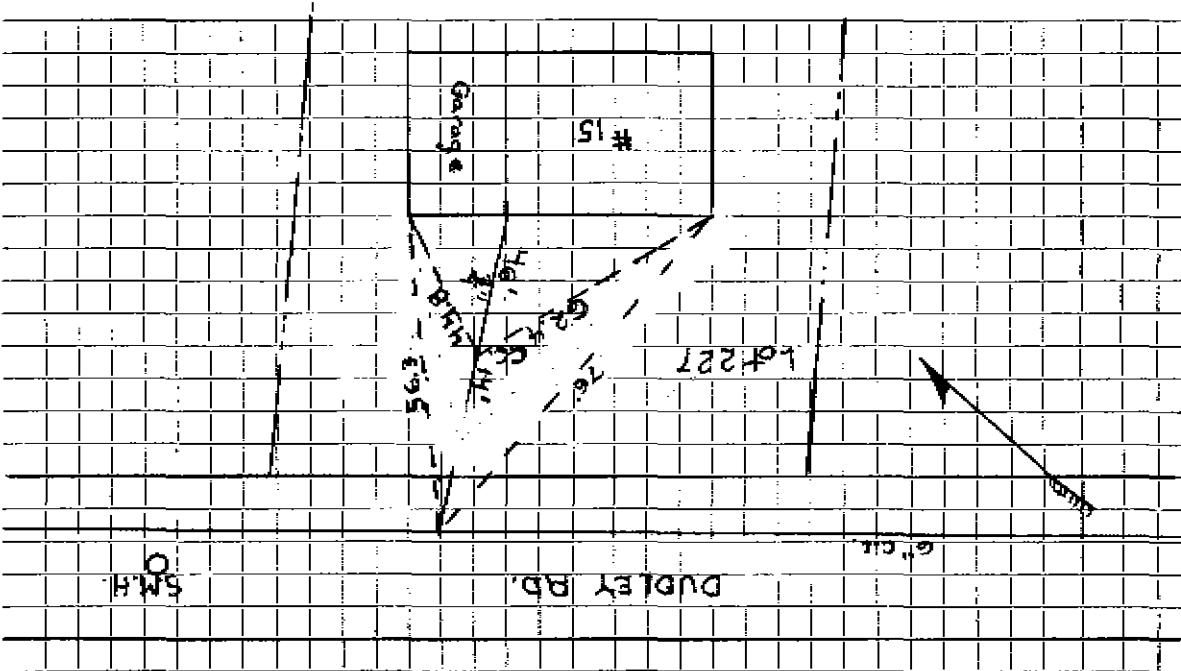

Sketch of Service Here

WATER DIVISION

TOWN OF LEXINGTON - BOARD OF PUBLIC WORKS

DATE