

Service No. 755

Address

ireb170
Dunham Fed.

Location

Dunham Fed.

Kind of Pipe

Size

Size of Main

Repair—Renewal—New Service

Location

Date

Material

Amount

Total

Date

Amount

Labor

DATE _____

TOWN OF LEXINGTON—BOARD OF PUBLIC WORKS

WATER DIVISION

The undersigned applies for a supply of water at No. _____ St. and hereby agrees to comply with the rules and regulations as now, or at any future time, established by the Board of Selectmen.

Am't. of Estimate \$ _____

Owner


S. Trebino

Am't. Paid \$ _____

Address

Dunham Rd.

Builder _____

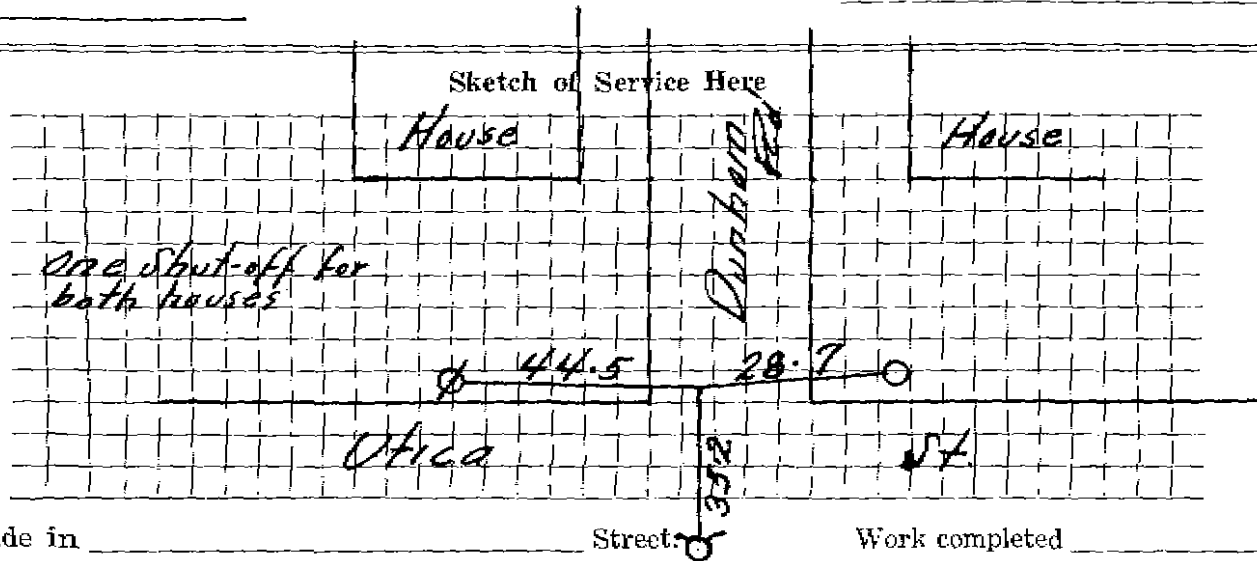

Connection made in _____

Street: _____

Work completed _____

19 _____

Remarks: