

6188

WATER SERVICE RECORD

Name Anthony DiRocco

Service No. 105 N.D.

Address 12 Dunham Road

Location

~~Revised General~~ New Service W.O. #9195

Comm 9-21-64

Date	Material	Amount	Total	Date	Amount
8-17-64	Labor	20.62		11-23-64	68.85
	10% O.H.	2.06	22.68	Paid	
	24' 3/4" C Copper tubing @.42		10.08		
	1 3/4" C Corp. Cock		4.91		
	1 3/4" C Curb Cock		6.28		
	1 Box & Rod		4.90		
	2 hrs. Town Shovel @6.50		13.00		
	1 hr. Trucking @3.00		3.00		
	1 hr. Loader @4.00		4.00		
			68.85		


Bill 501 65 85

DATE _____

TOWN OF LEXINGTON — BOARD OF PUBLIC WORKS

WATER DIVISION

Sketch of Service Here

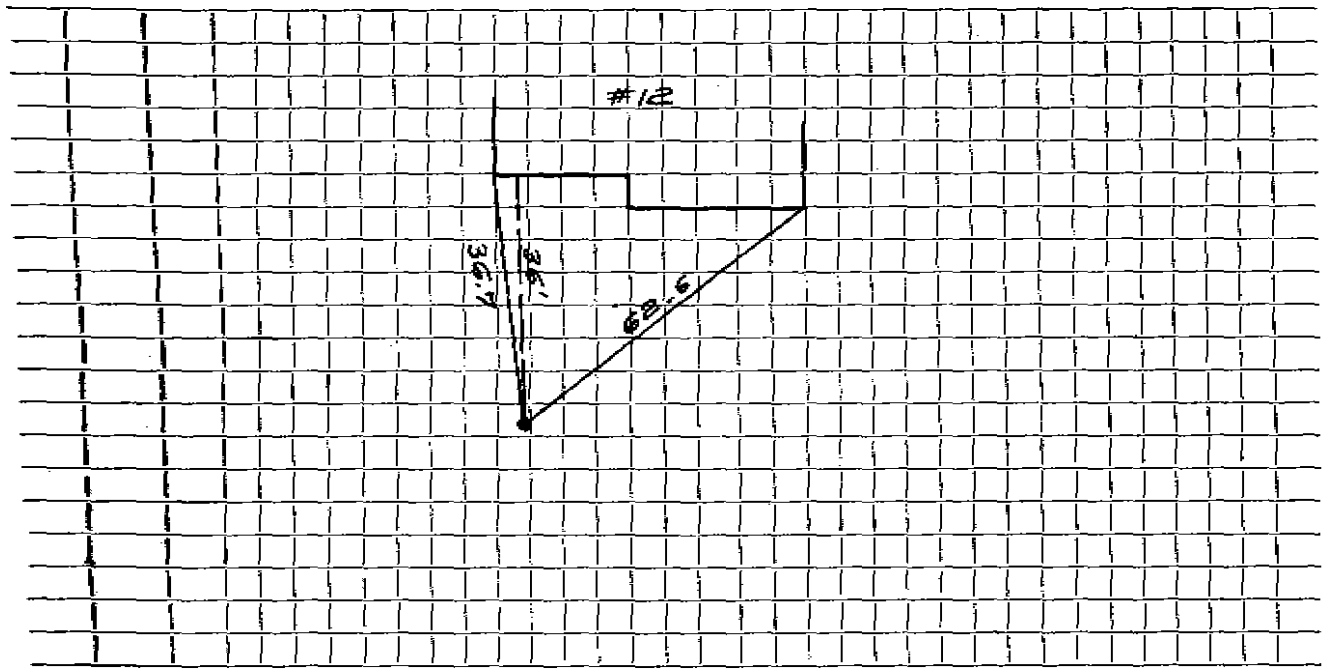

Connection made in _____ Street. Work completed

Remarks:
.....
.....