

WATER SERVICE RECORD

Name *Mr. Powers*

Service No.

Address *7 Dunham Street*# *1757*

Location

~~Repair~~ *New Service Renewal - Redmond #3854*


Date	Material	Amount	Total	Date	Amount
8-17-64	Labor	20 62			
	10% O.H.	2 06	22 68		
	11' 3/4" Copper tubing @ 42		4 62		
	1 3/4" C Corp Cock		4 91		
	1 3/4" C Curb Cock		6 28		
	1 Box & Rod		4 90		
	1 1" L.L. coupling		60		
	1 1" X 4" C L Nipple		28		
	1 1" Style 38 Coupling		3 43		
	1 Hr Town Shovel @ 6.50		6 50		
	1 Hr Trucking		3 00		
	1 Hr Loader		4 00		
	(BILL WHEN CONNECTED)		61 20		
10/24/83	40' 3/4" Copper tubing				

DATE _____

TOWN OF LEXINGTON — BOARD OF PUBLIC WORKS

WATER DIVISION

Sketch of Service Here

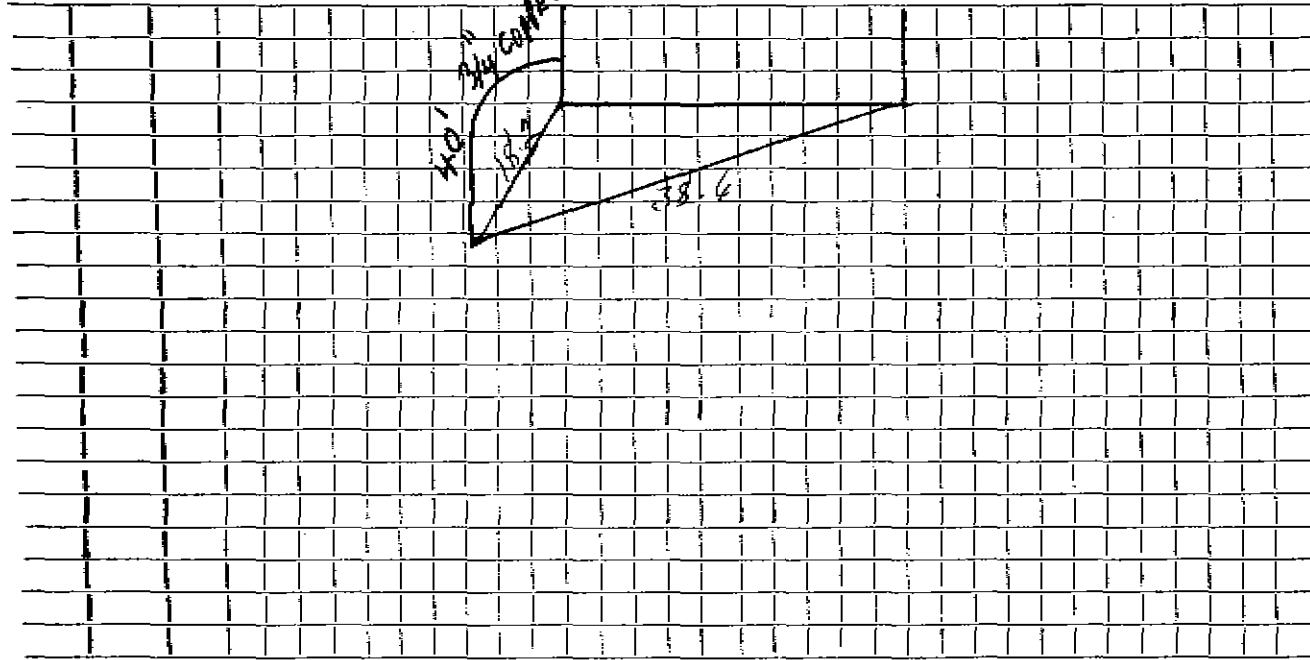

Connection made in Street. Work completed

Remarks:
.
.