

WATER SERVICE RECORD

977

Name

Service No.

Address 8 Dunham Street

Location

~~Renewal~~ - New Service


Date	Material	Amount	Total	Date	Amount
8-18-64	Labor	20 62			
	10% O.H.	2 06	22 68		
	33' 3/4" Copper tubing @ .12		13 86	8-95	Renewal work
	1 3/4" C. Corp Cock		4 91		
	1 3/4" C. Curb Cock		6 28		
	1 Box & Rod		4 90		
	1 2" Style 38 Coupling		4 30		
	1 2" X 1" Reducing Coupling		3 43		
	1 2 X 6 C L Nipple		31		
	1 Hr Trowl Shovel		6 50		
	1 Hr Trucking		3 00		
	1 Hr Loader		4 00		
	(BILL WHEN CONNECTED)		74 17		

DATE _____

TOWN OF LEXINGTON — BOARD OF PUBLIC WORKS

WATER DIVISION

Sketch of Service Here

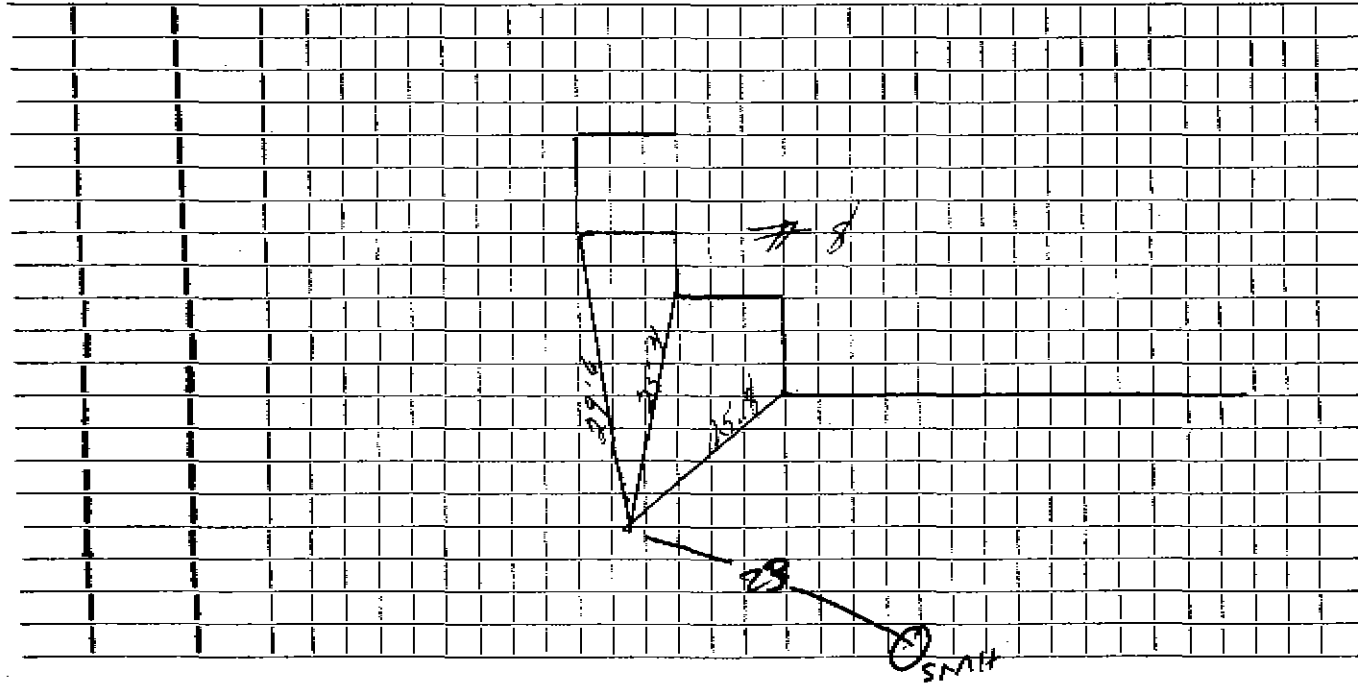

Connection made in Street. Work completed

Remarks: ... *Z. S. ... mch/feb. (1 for later use)*