

4086

WATER SERVICE RECORD

Name William H. Sullivan

Service No. 13

Address 9 Dunham Street

Location

REPAIR/RENEWAL - New Service

Comm 5-9-66

Date	Material	Amount	Total	Date	Material	Amount
4-13-60	Labor	2 37		3-23-60	Deposit	50 00
	10 % O.H.	24	2 61	5-9-60	Part of [unclear] Retard	21 78
4-6	3/4" Copper tubing @ .42	19 32				28 52
1	3/4" CX1/2 IWH Stop & Waste	5 84				
1	Hr. Trucking @ .75		75		Labor	2 11
			28 52	60	3/4" Copper tubing @ .42	25 20
				1	3/4" C Corp Cock	4 64
8-17-61	Labor	27 49		1	3/4" C Curb Cock	6 03
	10% O.H.	2 75	30 24	1	2x1" Lead lined tee	1 43
	5' 3/4" Copper tubing @ .42	2 10		1	2" Style 38 Clamp	2 60
	1 3/4" C. Corp Cock	4 91		1	Box & Rod	5 00
	1 3/4" C Curb Cock	6 28		1	1/2 Straight tailpiece	50
	1 Box & Rod	4 90		1	1/2 Offset tailpiece	50
	1 Hr Town Shovel @ 6.50	6 50				48 01
	1 Hr Trucking @ 3.00	3 00				
	1 Hr Loader @ 3.00	3 00				
	(BILL WHEN CONNECTED)		60 93			


* Applied to SMC # 13

DATE _____

TOWN OF LEXINGTON — BOARD OF PUBLIC WORKS

WATER DIVISION

Sketch of Service Here

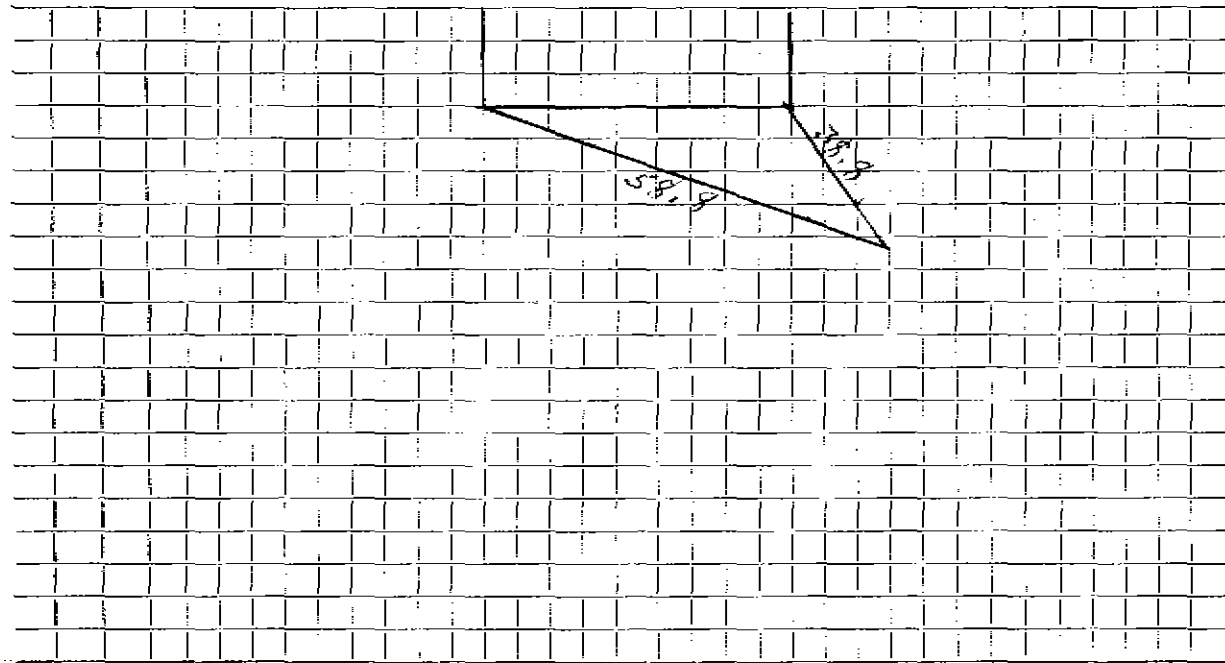

Connection made in Street. Work completed

Remarks:
.....
.....