




DATE \_\_\_\_\_

TOWN OF LEXINGTON — BOARD OF PUBLIC WORKS  
**WATER DIVISION**

Sketch of Service Here

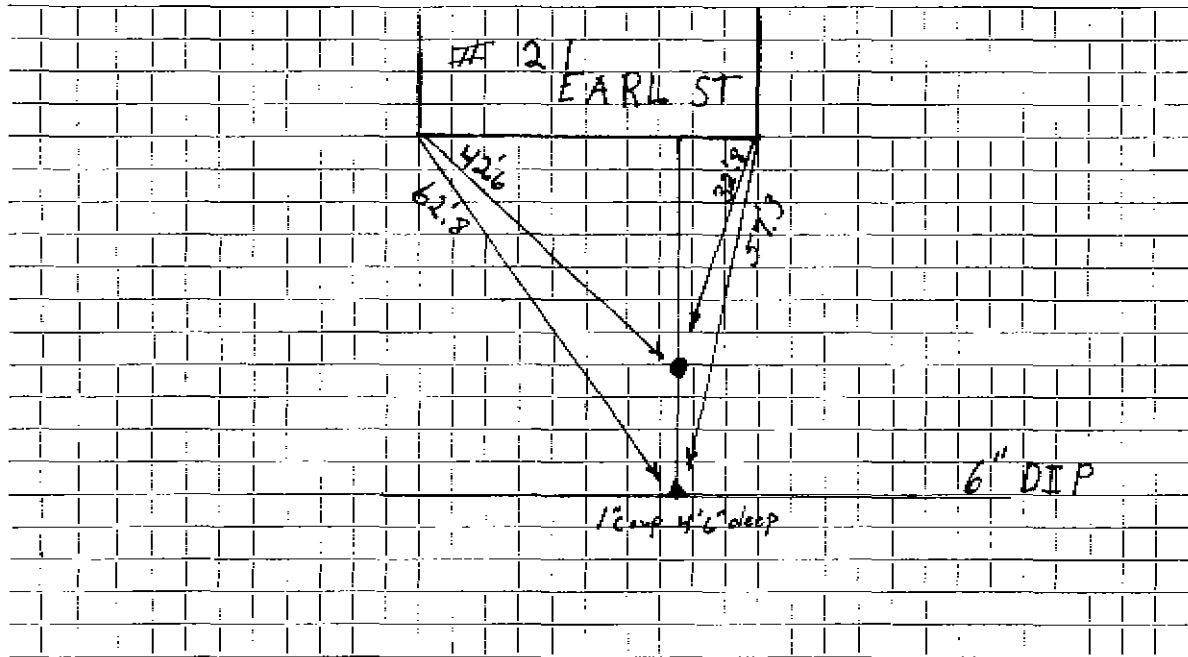

Connection made in EARL ST ..... Street.      Work completed 7-17-85 .....

Remarks: .....

.....

.....