

WATER SERVICE RECORD

Name James Razzono

Service No. 70

Address 24 Earl St.

Location

Repair - ~~General~~ New Service
~~water meter to be installed~~ WO #5173 Kel-Scot #2897

MAY 9, 1977


Date	Material	Amount	Total	Date	Amount	
12/16/76	Labor	69. 88		12-17-76	Deposit	172. 40
	10%OH	<u>6. 99</u>	76. 87	5-9-77	Paid by SHC # 103	<u>79. 50</u>
100'	1" Copper @ .83		83. 00			251. 90
1	1" 3 part union		10. 67			
1	1" curb.		18. 67			
1	1" corp.		16. 69			
1	curb box and rod		13. 00			
1	hr. trucking @ 3.00		3. 00			
4	hr. shovel @ 6.50		26. 00			
1	hr. loader @ 4.00		<u>4. 00</u>			
			251. 90			
12/20/76	42' 1" copper					

DATE _____

TOWN OF LEXINGTON — BOARD OF PUBLIC WORKS

WATER DIVISION

Sketch of Service Here

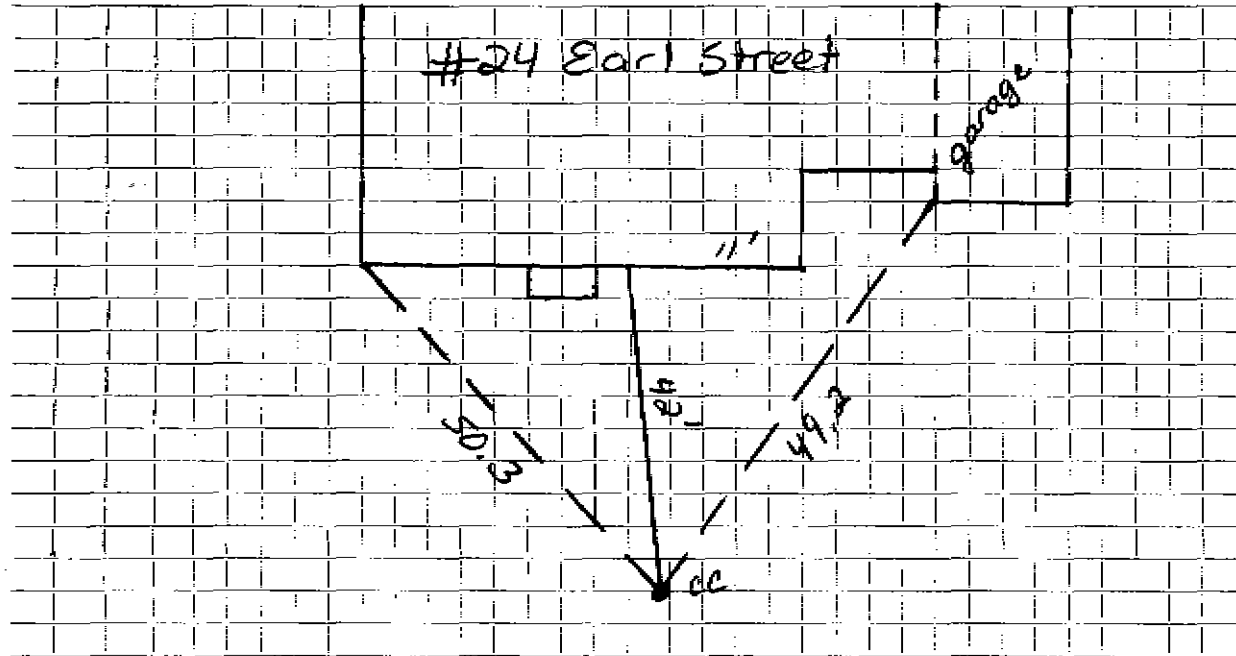

Connection made in Street. Work completed

Remarks:

.....

.....