

WATER SERVICE RECORD

Name Thomas Small

Service No. 291

Address 26 Earle Street

Location

~~Repair - Renewal~~ - New Service

Comm 3-64


Date	Material	Amount	Total	Date		Amount
12-6-60	Labor	3.83		11-29-60	Deposit	50.00
	10% O.H.	.38	4.21	3-2-61	Retained	9.51
20'	3/4" Copper tubing @.42		29.40			45.19
1	3/4" C x 1/2" I.W.H. Stop & Waste		6.17		NON CHARGE	
1	3/4" C 3 part union		2.41	12-6-60	Labor	1.94
1	hr. Trucking @3.00		3.00	22'	3/4" Copper tubing @.42	9.24
			45.19	1	3/4" C Corp Cock	4.91
				1	3/4" C Curb Cock	6.28
				1	Box & Rod	4.90
				1	1/2" Straight tailpiece	.50
				1	1/2" Offset tailpiece	.50
						28.27

DATE _____

TOWN OF LEXINGTON — BOARD OF PUBLIC WORKS

WATER DIVISION

Sketch of Service Here

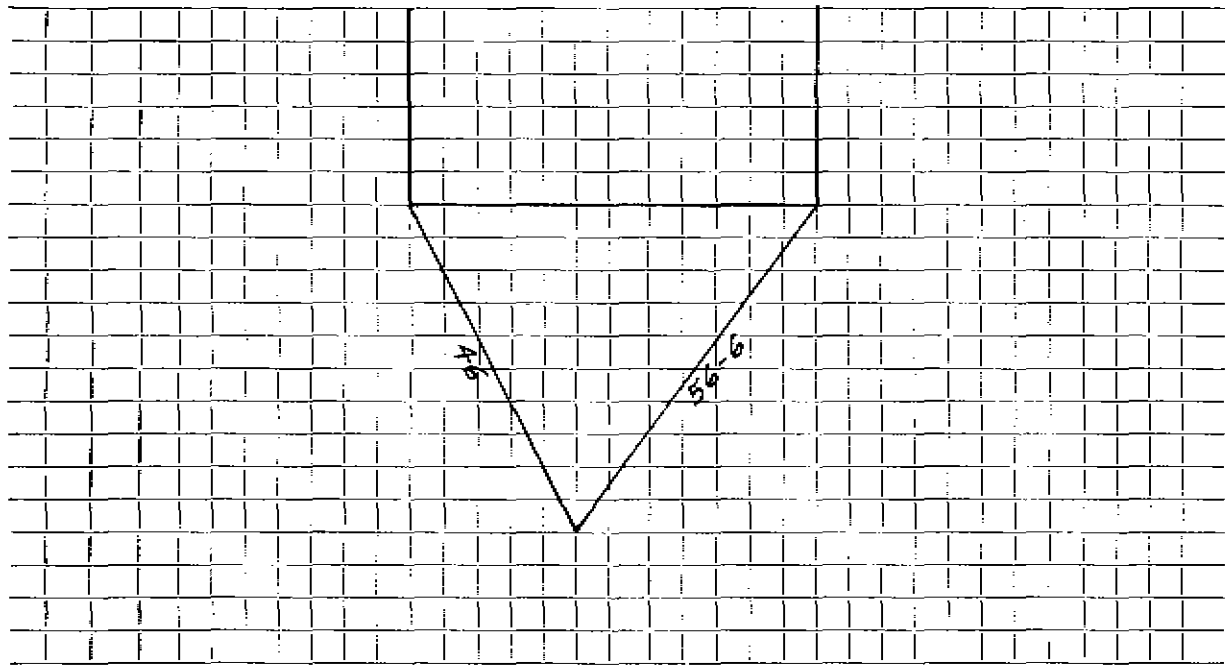

Connection made in Street. Work completed

Remarks:
.....
.....