

WATER SERVICE RECORD

3358

Name Robert Burg

Service No. 263

Address 34 Earl Street

Location

~~XXXXXX~~ ~~XXXXXX~~ New Service

Comp 12-31-60


Date	Material	Amount	Total	Date	Material	Amount
11-18-60	Labor	1.94		11-2-60	Deposit	50.00
	10% O.H.	.19	2.13	12-31-60	Retaind	14.99
60'	3/4" Copper tubing @.42		25.20			35.91
1	3/4" C x 1/2 I.W.H. Stop & Waste		6.17		NON CHARGE	
1	3/4" C 3 part union		2.41	11-18-60	Labor	1.94
			35.91	54'	3/4" Copper tubing @.42	22.68
				1	3/4" C Curd Cock	6.28
				1	3/4" C Corp Cock	4.91
				1	Box & Rod	4.90
				1	1/2 Straight tailpiece	.50
				1	1/2 Offset tailpiece	.50
						41.71
				7/99	1 1" CORP	
					1 1" UNIONS	
					10' 1" Copper	

DATE _____

TOWN OF LEXINGTON — BOARD OF PUBLIC WORKS

WATER DIVISION

Sketch of Service Here

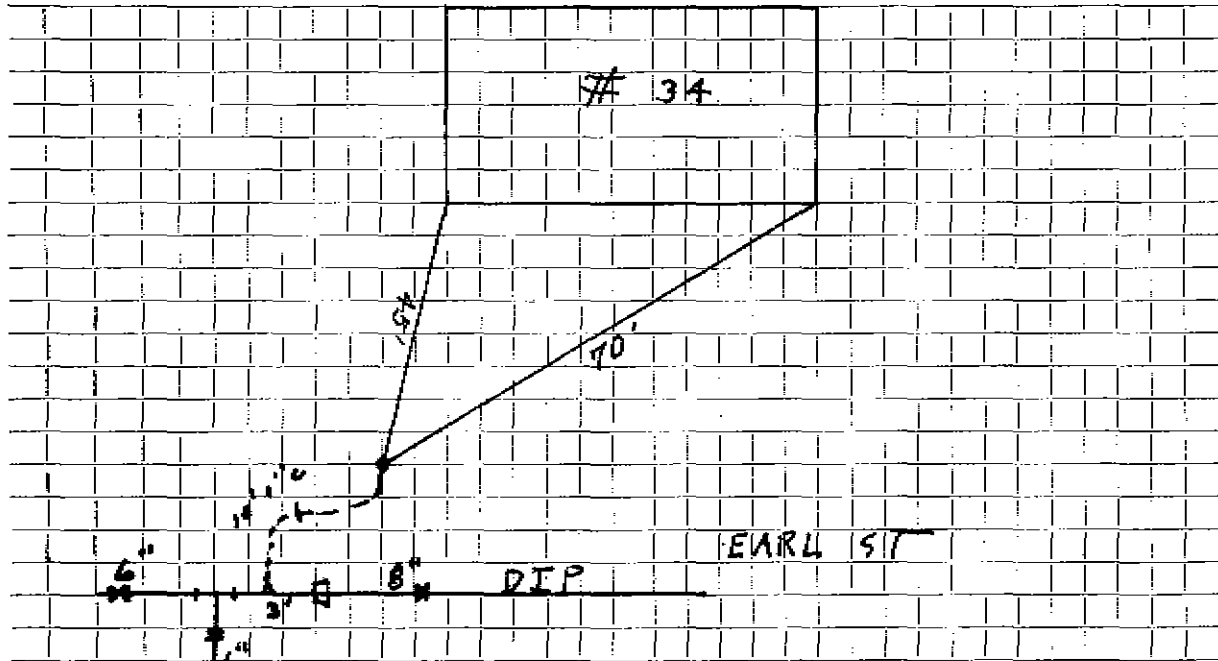

Connection made in Street. Work completed

Remarks:

.....

.....