

WATER SERVICE RECORD

Name

Service No.

Address 43 EARL STREET (LOT B)

Location


Repair—Renewal—New Service CONTRACTOR: J.M. McGLAVELIN IN-FLOWERS PERMIT 1386

Date	Material	Amount	Total	Date	Amount
SEPT 1999	1 CURBSTOP / BOX			SEPT 1999	
	1 BUFFALO BOX			16' 1" COPPER	
				1 1" CORPORATION	
4/25/00	42' 1" COPPER 1" VALVE				

DATE SEPT 1999

TOWN OF LEXINGTON — BOARD OF PUBLIC WORKS  
WATER DIVISION

Sketch of Service Here

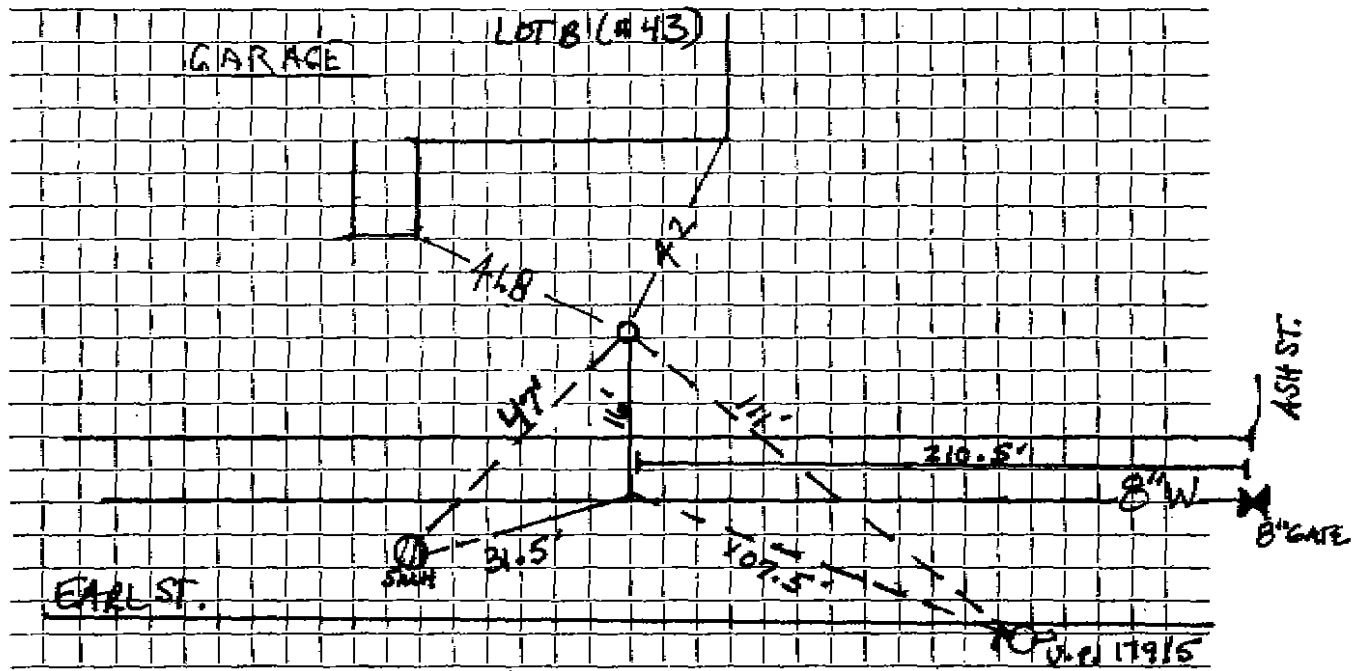

Connection made in EARL ST. Street. Work completed .....

Remarks: .....