




DATE \_\_\_\_\_

TOWN OF LEXINGTON — BOARD OF PUBLIC WORKS  
WATER DIVISION

Sketch of Service Here

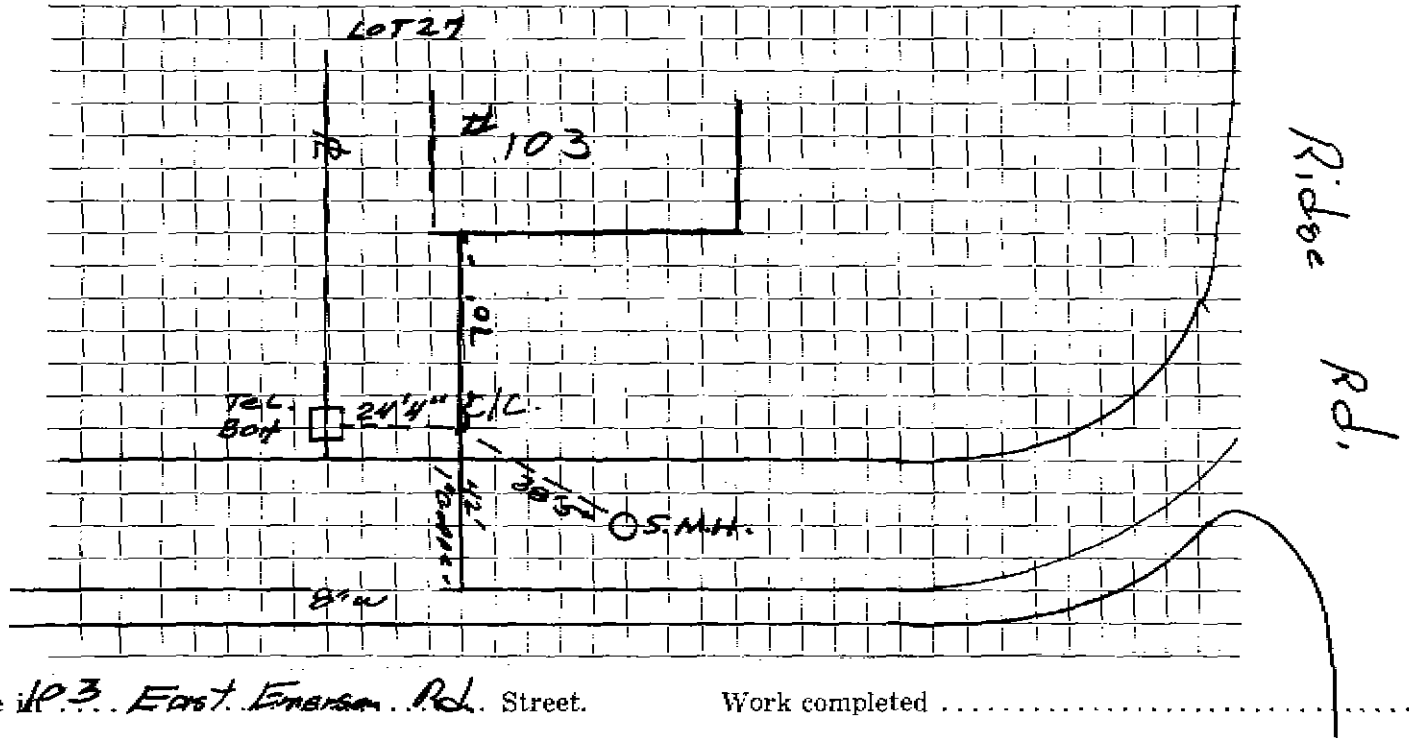

Connection made in # 103 East Emerson Rd. Street. Work completed .....

Remarks: .....

.....

.....