




DATE \_\_\_\_\_

TOWN OF LEXINGTON - BOARD OF PUBLIC WORKS  
WATER DIVISION

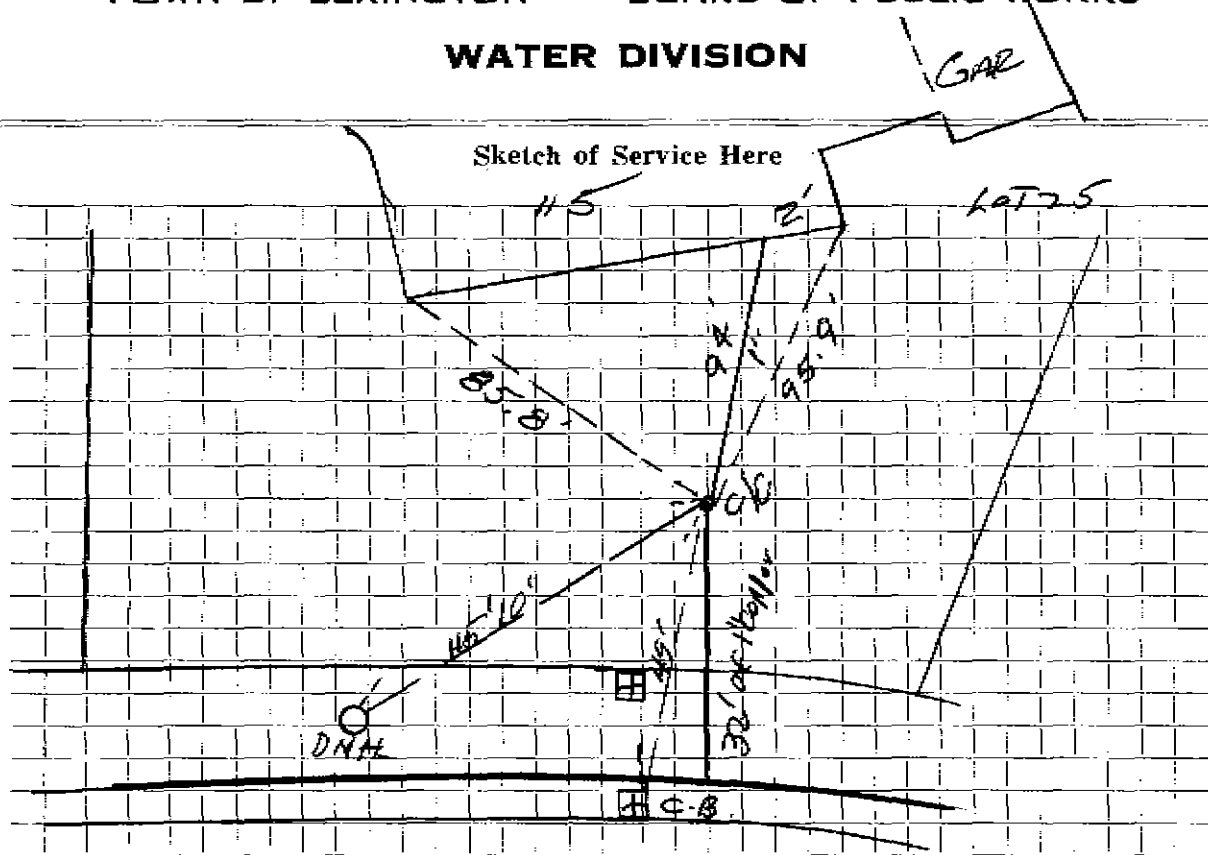

Connection made in EAST EMERSON Street. Work completed .....

Remarks: .....

**WATER SERVICE RECORD**

Name

Service No.

Address #116 East Emerson Rd.

Location

Lot 29


Repair—Renewal—(New Service)

Date	Material	Amount	Total	Date	Amount
1984	25' of 1" Copper	N/C			
	① COP.				
	② c/c i' bot				
12/18/88	51 ft. 1" Copper	N/C			
	①				

DATE \_\_\_\_\_

TOWN OF LEXINGTON — BOARD OF PUBLIC WORKS  
**WATER DIVISION**

Sketch of Service Here

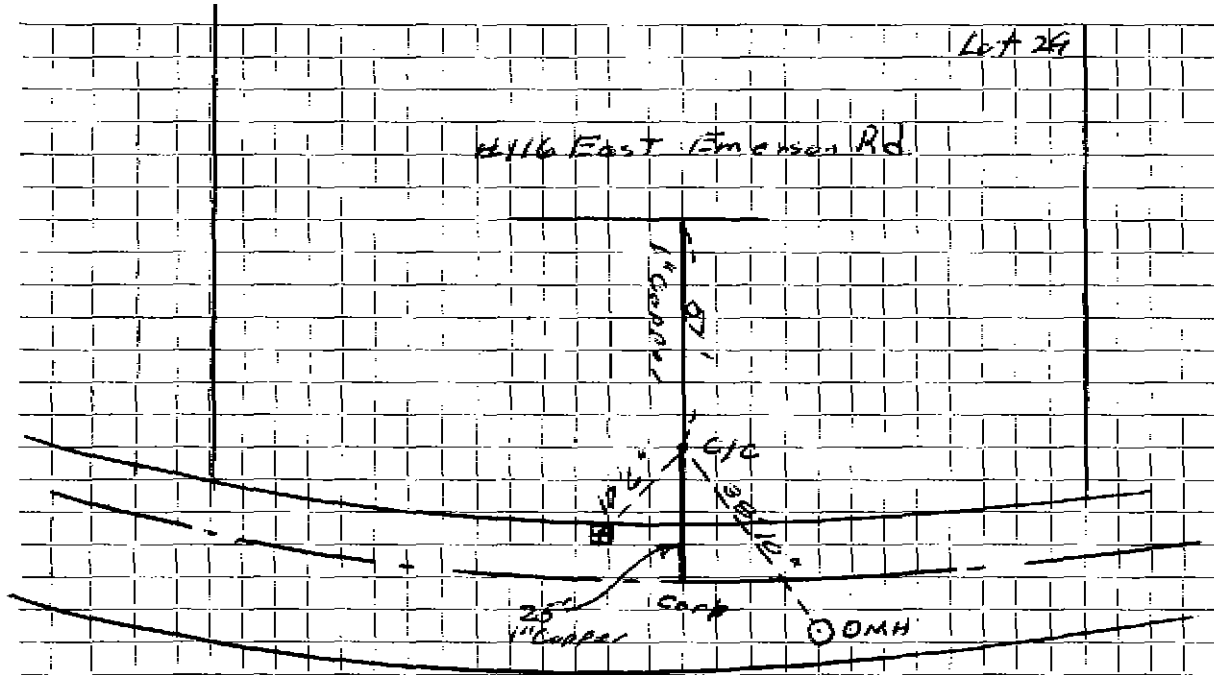

Connection made in East Emerson Rd. Street. Work completed 12/89

Remarks: .....

.....

.....