


OKG

DATE _____

TOWN OF LEXINGTON — BOARD OF PUBLIC WORKS WATER DIVISION

Sketch of Service Here

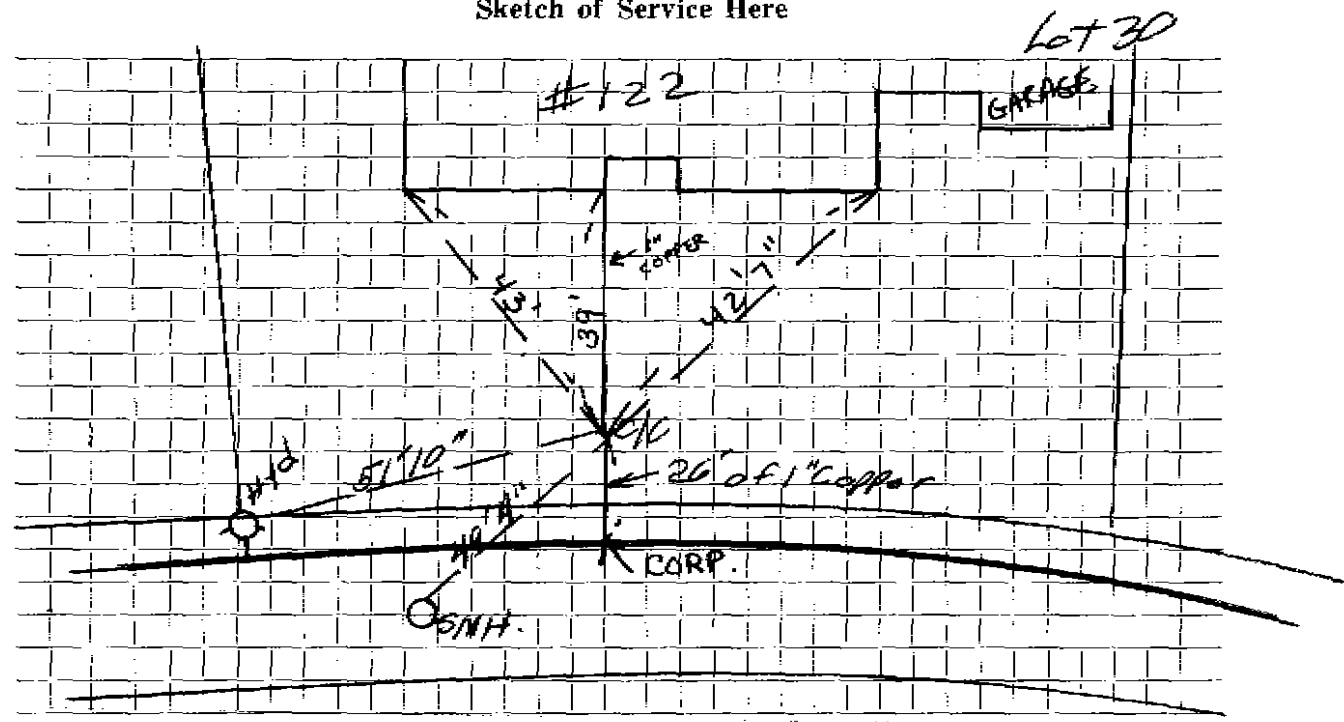

Connection made in EAST EMERSON Street. Work completed

Remarks:
.....
.....