

WATER SERVICE RECORD

Name Prescott Realty

Service No.

Address 130 EAST EMERSON

Location

Repair—Renewal—New Service At/EX 3977


Date	Material	Amount	Total	Date	Amount
6-11-85	INSIDE				OUTSIDE
	54' 1" COPPER			1	1" CURB
	1 1" WHEEL HANDLE			1	1" CORR
				1	BOX + ROD
				17'	1" COPPER
	9'3" DEEP AT FOUNDATION				

DATE _____

TOWN OF LEXINGTON — BOARD OF PUBLIC WORKS

WATER DIVISION

Sketch of Service Here

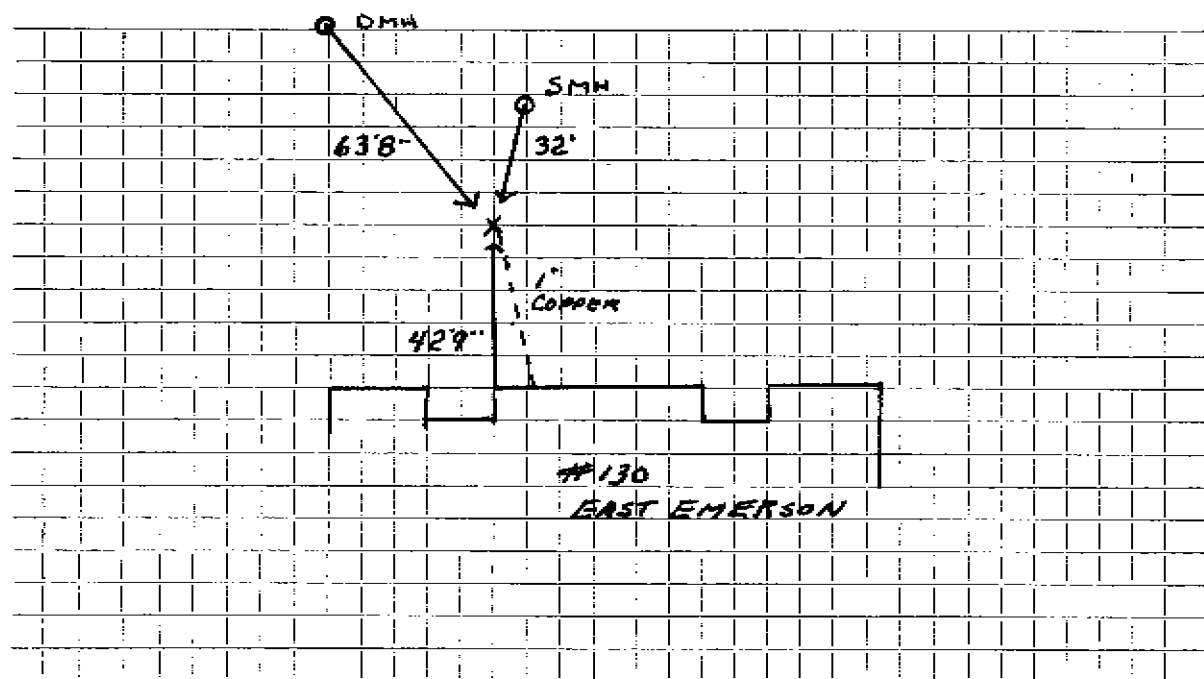

Connection made in Street. Work completed

Remarks:
.....
.....