


DATE MARCH 15, 1985

TOWN OF LEXINGTON — BOARD OF PUBLIC WORKS
WATER DIVISION

Sketch of Service Here

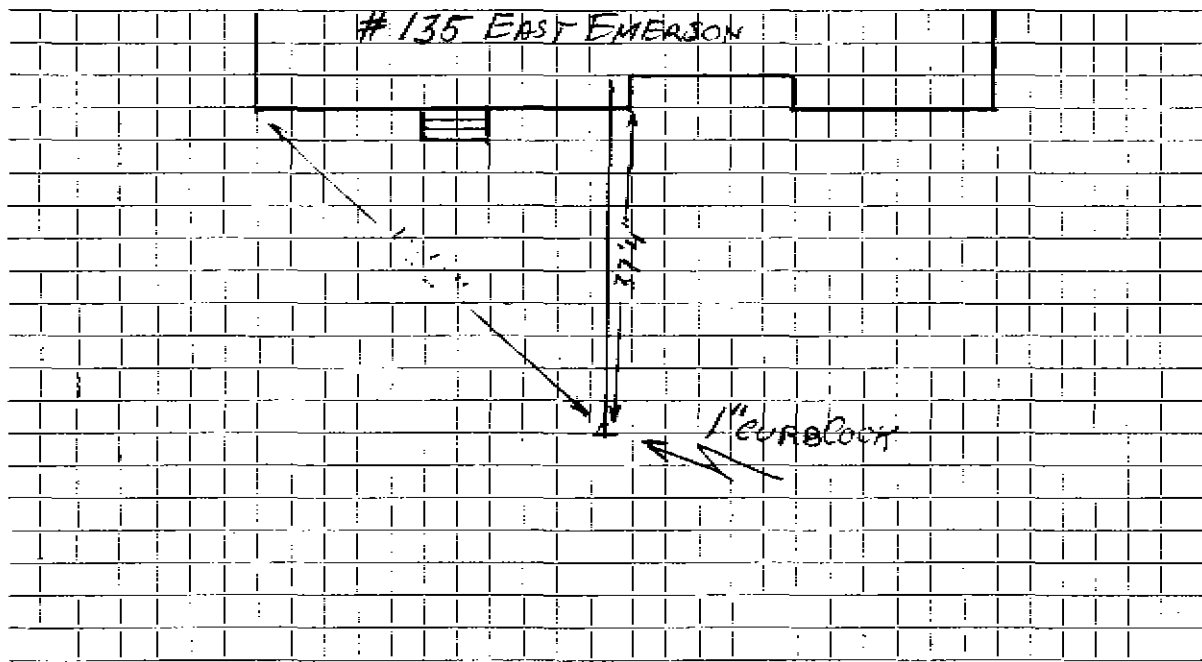

Connection made in EAST EMERSON RD Street. Work completed MARCH 1985

Remarks:

.....

.....