




DATE \_\_\_\_\_

TOWN OF LEXINGTON — BOARD OF PUBLIC WORKS

**WATER DIVISION**

Sketch of Service Here

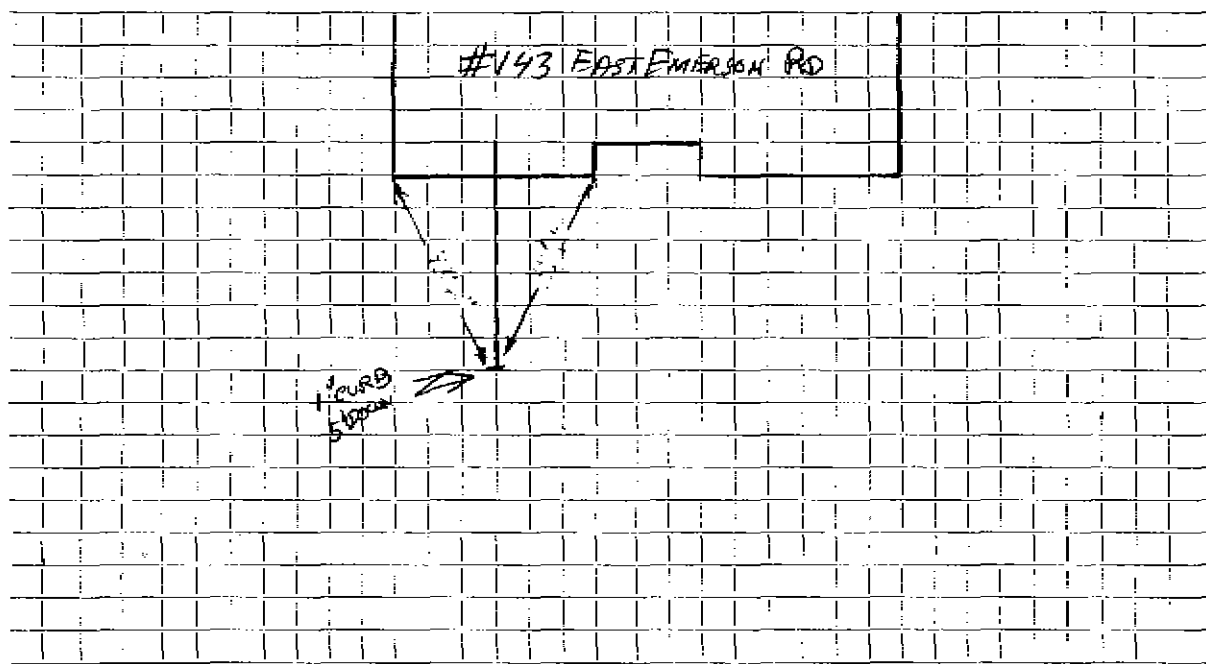

Connection made in EAST EMERSON RD Street.

Work completed SEP 10, 1984

Remarks: .....

.....

.....