




DATE \_\_\_\_\_

TOWN OF LEXINGTON — BOARD OF PUBLIC WORKS

WATER DIVISION

Sketch of Service Here

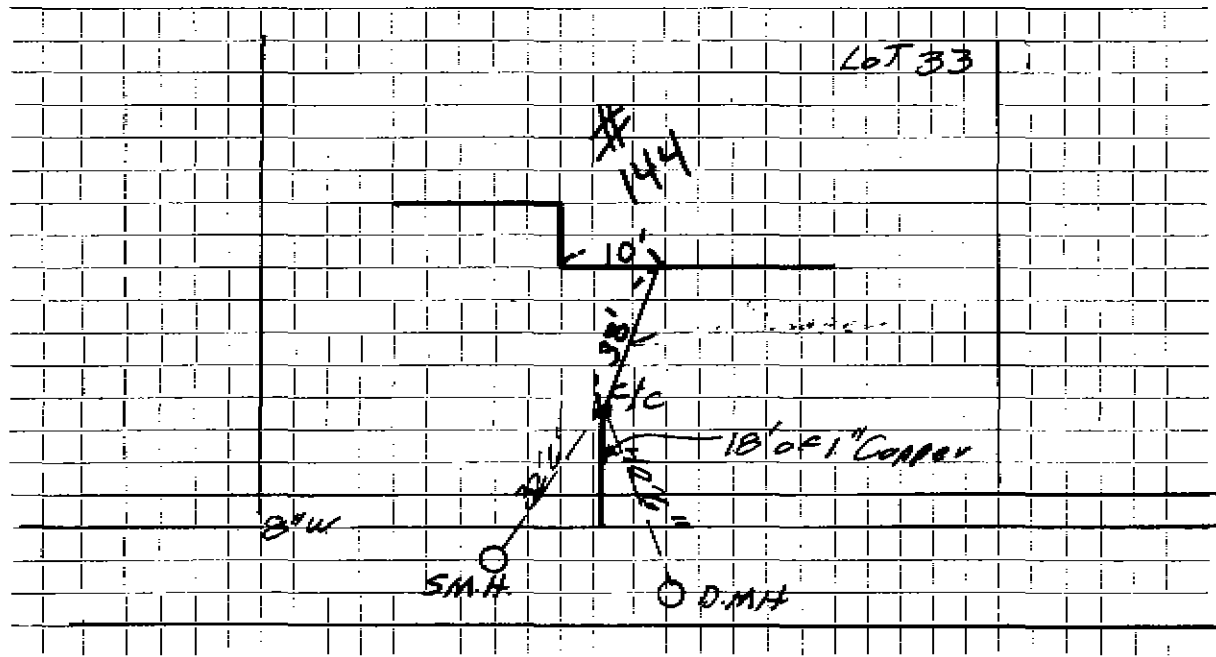

Connection made in 144 East Emerson Ad Street. Work completed .....

Remarks: .....

.....

.....